

Stafford


KANSAS

Form 51-5M 5-37 Petrol

Section 29 Township 22 Range 11-W


Well No. 4 Wm. Spangenberg

Company Stanolind

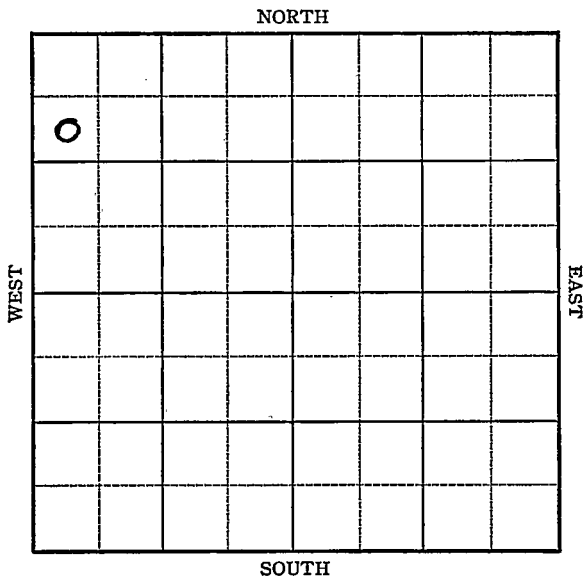

Sec. 29 Twp. 22 R. 11-WWell No. #4 Wm. Spangenberg FarmStanolind Company990 Ft. from N. Line Ft. from S. Line Ft. from E. Line330 Ft. from W. Line

Elev. 1840

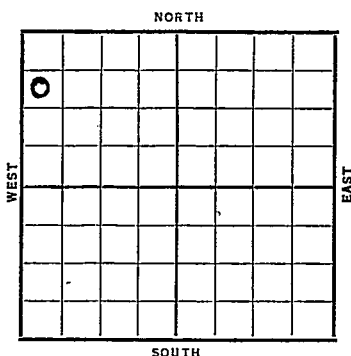

Date	REPORT
1937	
11/3	R U R
11/12	13" @ 2225'. Anhy 572'.
	Drlg. 2160'.
11/19	Drlg. 3475'.
11/26	Sil. & 6" @ 3578'.
	T.D. 3582'. No shows rep.
	RUST.
12/3	" " "
12/10	" " "
12/17	T.D. 3600'. 4500 acid.
	SW PB.
12/24	P.B. 3595'. 200' oil & 800'
	water. P.B. 3593'.
12/31	" " " "
1938	
1/7	T.D. 3596'. 60 shots 3578-96'.
	Drlg. deeper.
	OVER

1938

1/14 T.D. 3623'. 2500' oil.
2000 acid. Swab 45 bbls. oil
per hr. off bottom.

1/19 6" @ 3578'.
Arb. 3578'.
T.D. 3623'.
6500 acid.
Potential 1085 bbls.

COMPLETED

Stafford

KANSAS

Map No. _____ Sec. 29 Twp. 22 R. 11WWell No. 4 Wm. SpangenbergStanolind Company

Contractor _____

FIRST REPORT

SW NW NW

990 Ft. from N. Line

_____ Ft. from S. Line

_____ Ft. from E. Line

330 Ft. from W. Line

SECTION PLAT

0			

Location _____

Rig up _____

Drilling and Remarks:

RUR

RECORD

Cased _____ in., _____ ft.

Sand _____

Gas _____

Oil _____

Total Depth _____

PRODUCTION

1st 24 hrs Nat. _____

1st 24 hrs after shot _____

Gas _____ Cu. Ft.

Dry Hole _____

Abandoned _____

Date

NOV 3 1937 19 H. D. Hatfield Scout

Stafford KANSASMap No. 76 Sec. 29 Twp. 22 R. 11WWell No. 4 Wm. SpangenbergStanolind

Company

Contractor

COMPLETED

SW NW NW

990 Ft. from N. Line

_____ Ft. from S. Line

_____ Ft. from E. Line

330 Ft. from W. Line**SECTION PLAT**

0			

Location _____

Rig up _____

Drilling and Remarks:

*6500 acid**PT 1085***RECORD**Cased 6 in., 3578 ft.Sand 4-6 3578

Gas _____

Oil _____

Total Depth 3623**PRODUCTION**

1st 24 hrs. Nat. _____

1st 24 hrs. after shot _____

Gas _____ Cu. Ft.

Dry Hole _____

Abandoned _____

Date

JAN 19 1938

19

H. D. Hatfield Scout