


KANSAS

Form 51-5M-11-31-Palace

Map No. _____ Sec. 29 Twp. 22 R. 3 WWell No. 1 Shissey Farm _____United Pet Co Et al Company

NORTH

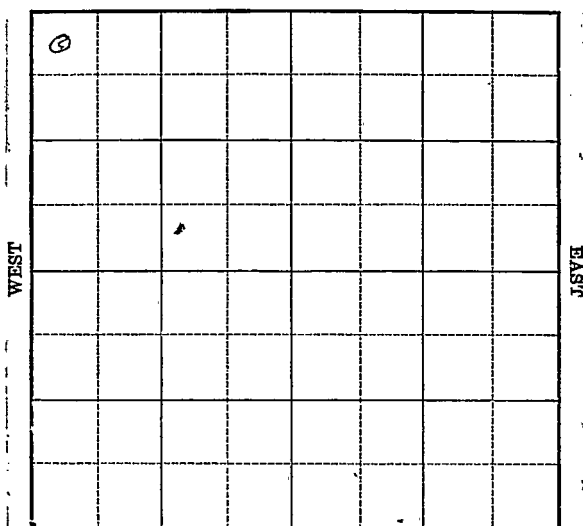

SOUTH

Location _____

Drilling Remarks _____

Rig Up _____

Drilling Remarks _____

RECORD

Cased _____ in. _____ ft.

Sand _____

Gas _____

Oil _____

Total Depth _____

PRODUCTION

1st 24 hrs. Nat. _____

1st 24 hrs. after shot _____

Gas _____ cu. ft.


Dry Hole _____

Abandoned _____

Map No. _____ Sec. 29 Twp. 22 R. 3^WWell No. #1 Thuesen Farm
United Pet. Co. et al Company330 Ft. from N. Line

_____ Ft. from S. Line

_____ Ft. from E. Line

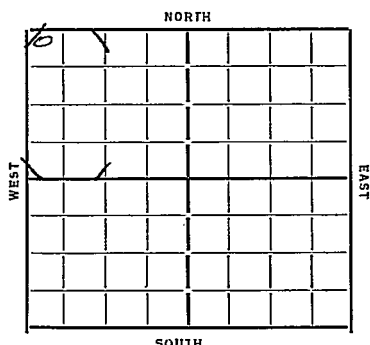330 Ft. from W. LineDate
1933

REPORT

3/22 Slush pond3/29 Bldg rig3/44 Spud 190'4/12 drlg 1010'4/15 " 2950'4/20 Top Chat 3181 show oil + water
3215 drlg 3235'5/4 Bare line 3383 Hunton 3488-89
Cement 6"5/10 Bailing5/17 Top Hunton S.M. 3498 show oil +
1 Bailed water 3519-22' (Base Hunton)
3538' T.D. 3553 1000 gal acid
No test.5/24 Hunton 3498-3538show oil 1 barrel
3519-221000 Gallon acid
no result
Abandoned 3553'
(Completed)

Harvey
 43 KANSAS Sec. 29 Twp. 22 R. 3^W
 Map No.

Well No. 1 Thiessen

united per Co. Co. al Company

Contractor

FIRST REPORTS


330 Ft. from N. Line

Ft. from S. Line

Ft. from E. Line

330 Ft. from W. Line

SECTION PLAT

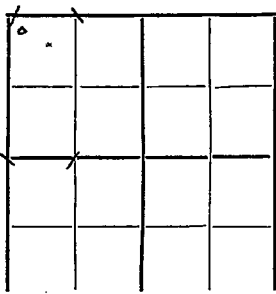

Location

Rig up

Drilling and Remarks:

Shut W Pond

RECORD

Cased in., ft.

Sand

Gas

Oil

Total Depth

PRODUCTION

1st 24 hrs. Nat.

1st 24 hrs. after shot

Gas Cu. Ft.

Dry Hole

Abandoned

Date

MAR 22 1933

192

CHAS. L. SHERWOOD

Scout

43

Map No. KANSAS Sec. 29 Twp. 22 R. 3 ^W

Well No. 1 Thiessen

United Oil Co of Company

Contractor

COMPLETED

330 Ft. from N. Line

_____ Ft. from S. Line

_____ Ft. from E. Line

330 Ft. from W. Line

ABANDONED

SECTION PLAT

o			

Location_____

Rig up_____

Drilling and Remarks:_____

Show Oils 1 Bw
3519-22
1000 gal acid
no result

RECORD

Cased in. 3 ft.
 Sand Hunter 3498-3538
 Gas_____
 Oil_____
 Total Depth 3553

PRODUCTION

1st 24 hrs. Nat._____
 1st 24 hrs. after shot_____
 Gas_____ Cu. Ft.
 Dry Hole ✓
 Abandoned ✓

Date

MAY 24 1933

CHAS. L. SHERWOOD

192

Scout