


Section 29 Township 22 Range 34W

Well No. 1 Altmann

Company Warren Pet.

Hugoton

NORTH

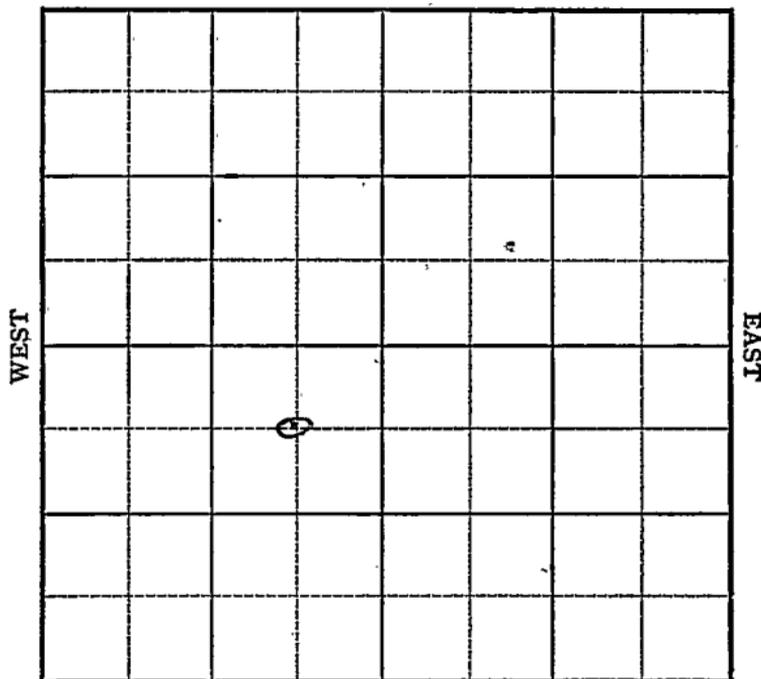

SOUTH

Sec. 29 Twp. 22 R.

Well No. #1 Altmann Farm

Warren Pet. Company

Hugoton (Burris, Cont.)


Pool 1
660' Ft. from N. Line

Ft. from S. Line

660' Ft. from E. Line

Ft. from W. Line

C NE SW

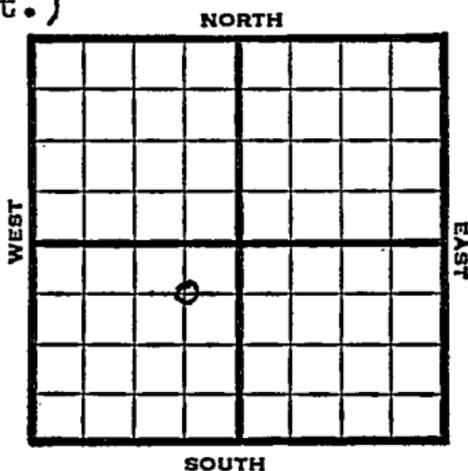

1949 Elev 2976' REPORT

7/20 RUR
7/27 10" @ 325'
Drlg 2064'

8/3 TD 2606'
7" @ 2490'

8/10 Drlg. 2574'

8/17 TD 2660'
Acid 7000'

8/24 TD 2660'
7" @ 2490'
315 qts
9000 acid
2596,000 Gas
380# R Pr
Comp

COMPLETED

Kansas

Map No. _____ Sec. 29 Twp. 22 R. 34W

Well No. 1 Altmann

Warren Pet. _____ Company

Burris _____ Contractor

C NE SW

FIRST REPORT
SECTION PLAT660 Ft. from N. Line

_____ Ft. from S. Line

660 Ft. from E. Line

_____ Ft. from W. Line

Finney County

Location _____

Rig up _____

Drilling and Remarks: _____

R U R

RECORD

Cased _____ in., _____ ft.

Sand _____

Gas _____

Oil _____

Total Depth _____

PRODUCTION

1st 24 hrs. Nat. _____

1st 24 hrs. after shot _____

Gas _____ Cu. Ft.

Dry Hole _____

Abandoned _____

Date

JUL 20 1949 19S. J. LEWIS Scout

