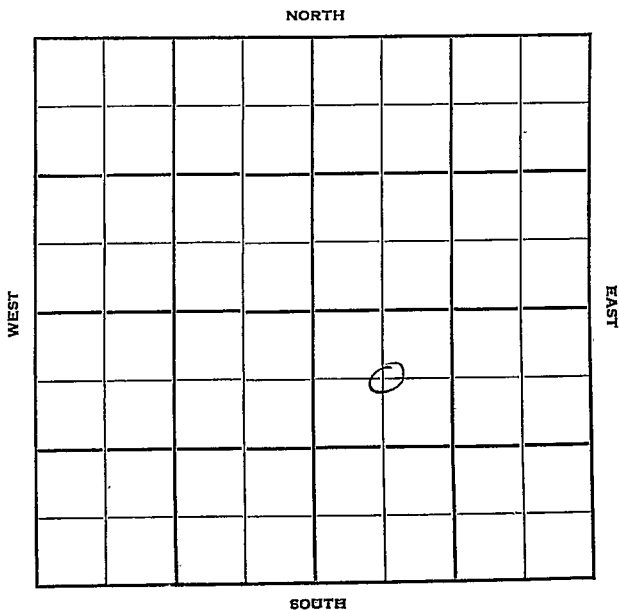


Section 29 Township 22 Range 35W ~~KAN~~Well No. #1 HedgesCompany Warren Petroleum

Kearny

KANSAS

Sec. 29 Twp. 22 R. 35W

Well No. #1 Hedges Farm

Warren Petroleum Company

Contractor

Hugoton Pool


660' Ft. from N. Line

Ft. from S. Line

Ft. from E. Line

660' Ft. from W. Line

C NW SE

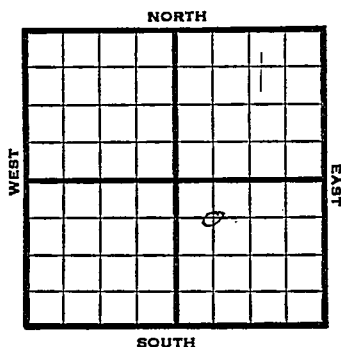

1950

Elev. 3089' REPORT

4/26

Location

6/21

10" @ 191'

7" @ 2539'

TD 2710'

100 qt/2640-45

Acid 22,000

Her. 2565-90

Win. 2620-45

180' of 5" liner

Comp. 7,200,000 gas 400#

COMPLETED

Kauaas

Hugoton Pool

Map No. _____ Sec. 29 Twp. 22 R. 35WWell No. 1 Hedges

Warren Petroleum Company

Contractor

C NW SE

SECTION PLAT

660 Ft. from N. Line

_____ Ft. from S. Line

_____ Ft. from E. Line

660 Ft. from W. Line

Kearny County

Location X

Rig up _____

Drilling and Remarks: _____

RECORD

Cased _____ in., _____ ft.

Sand _____

Gas _____

Oil _____

Total Depth _____

PRODUCTION

1st 24 hrs. Nat. _____

1st 24 hrs. after shot _____

Gas _____ Cu. Ft.

Dry Hole _____

Abandoned _____

Date

APR 26 1950 19

J. E. TYRA

Scout

Map No. _____ Sec. 29 Twp. 22 R. 35WWell No. 1 Hedges

Warren Pet.

Company


Contractor

C NW SE

El. 3089
SECTION PLAT660 Ft. from N. Line

_____ Ft. from S. Line

_____ Ft. from E. Line

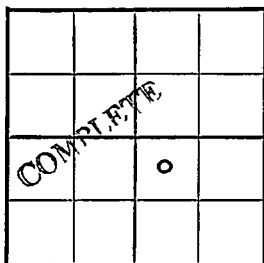660 Ft. from W. Line

Kearny County

Location _____

Rig up _____

Drilling and Remarks:

10" @ 191

7" @ 2539

TD 2710

100 qt/ 2640-45

22000 acid

RECORD

Cased _____ in., _____ ft.

Sand _____

Gas _____

Oil _____

Total Depth 2710

PRODUCTION

1st 24 hrs. Nat. _____

1st 24 hrs. after shot _____

Gas _____ Cu. Ft.

Dry Hole _____

Abandoned _____

Date

JUN 21 1950 -

19

J. E. TYRA Scout

Her. 2565-90

Win. 2620-45

180' of 5" liner

Comp. 7,200,000 gas 400#

Stamp: JUN 28 1950

Stamp: Scout Cards

Stamp: Land Small Map

Stamp: Land Wall Map

Stamp: Tracings

Stamp: France Map

Stamp: Pierce Map

Stamp: Misc.

SECURITY BY 71