

Map No. KANSAS Sec. 20 Twp. 22 R. 3 W  
 Well No. 1 School Lot  
F.H. Followe & Co Company  
 Contractor

**SECTION PLAT**

\_\_\_\_\_ Ft. from N. Line  
300 Ft. from S. Line  
300 Ft. from E. Line  
 \_\_\_\_\_ Ft. from W. Line

		0	

**FIRST REPORTS**

Location   
 Rig up \_\_\_\_\_  
 Drilling and Remarks:  
1 acre in Lot

**RECORD**  
 Cased \_\_\_\_\_ in., \_\_\_\_\_ ft.  
 Sand \_\_\_\_\_  
 Gas \_\_\_\_\_  
 Oil \_\_\_\_\_  
 Total Depth \_\_\_\_\_

**PRODUCTION**  
 1st 24 hrs. Nat. \_\_\_\_\_  
 1st 24 hrs. after shot \_\_\_\_\_  
 Gas \_\_\_\_\_ Cu. Ft.  
 Dry Hole \_\_\_\_\_  
 Abandoned \_\_\_\_\_

Date MAR 4 1931  
19  
S. J. LEWIS Scout

Form 26-1M Bks. - 9-28  
 Map No. KANSAS Sec. 20 Twp. 22 R. 3 W  
43  
 Well No. 1 School Lot  
F.H. Followe & Co Company  
 Contractor

**SECTION PLAT**

\_\_\_\_\_ Ft. from N. Line  
200 Ft. from S. Line  
 \_\_\_\_\_ Ft. from E. Line  
200 Ft. from W. Line

0			

**CORRECTION**

Location \_\_\_\_\_  
 Rig up \_\_\_\_\_  
 Drilling and Remarks:  
Reported OENW.

**RECORD**  
 Cased \_\_\_\_\_ in., \_\_\_\_\_ ft.  
 Sand \_\_\_\_\_  
 Gas \_\_\_\_\_  
 Oil \_\_\_\_\_  
 Total Depth \_\_\_\_\_

**PRODUCTION**  
 1st 24 hrs. Nat. \_\_\_\_\_  
 1st 24 hrs. after shot \_\_\_\_\_  
 Gas \_\_\_\_\_ Cu. Ft.  
 Dry Hole \_\_\_\_\_  
 Abandoned \_\_\_\_\_

Date MAR 11 1931  
192  
S. J. LEWIS Scout

*Harvey*

*Harvey*

**43 KANSAS**

*W*

Map No. \_\_\_\_\_ Sec. 20 Twp. 22 R. 3

Map No. 43 KANSAS Sec. 20 Twp. 22 R. 3

Well No. 1 *Fee*

Well No. 1 *Fee*

*F. H. Follow et al* Company

*F. H. Follow et al* Company

Contractor

Contractor

COMPLETED

SECTION PLAT

\_\_\_\_\_ Ft. from N. Line

700 Ft. from S. Line

\_\_\_\_\_ Ft. from E. Line

700 Ft. from W. Line


FIRST REPORTS

SECTION PLAT

\_\_\_\_\_ Ft. from N. Line

700 Ft. from S. Line

\_\_\_\_\_ Ft. from E. Line

700 Ft. from W. Line


*Old T.O. Reported as 3516*

Location \_\_\_\_\_

Rig up \_\_\_\_\_

Drilling and Remarks:

*Pump 114 Bls in 5 hours.*

*Shut in.*

RECORD

Cased \_\_\_\_\_ in., \_\_\_\_\_ ft.

Sand 3514 - 3516

Gas \_\_\_\_\_

Oil \_\_\_\_\_

Total Depth 3516

PRODUCTION

1st 24 hrs. Nat. \_\_\_\_\_

1st 24 hrs. after shot \_\_\_\_\_

Gas \_\_\_\_\_ Cu. Ft.

Dry Hole \_\_\_\_\_

Abandoned \_\_\_\_\_

Location \_\_\_\_\_

Rig up \_\_\_\_\_

Drilling and Remarks:

*5/16" Correction*

*Top Huntan 3507*

*Old T.O. 3509*

*Deepened to 3512*

*Flow 1456 Bls*

*in 25 Hours*

RECORD

Cased \_\_\_\_\_ in., \_\_\_\_\_ ft.

Sand \_\_\_\_\_

Gas \_\_\_\_\_

Oil \_\_\_\_\_

Total Depth 3512 *5/16"*

PRODUCTION

1st 24 hrs. Nat. \_\_\_\_\_

1st 24 hrs. after shot \_\_\_\_\_

Gas \_\_\_\_\_ Cu. Ft.

Dry Hole \_\_\_\_\_

Abandoned \_\_\_\_\_

Date

Date FEB 10 1932 **CHAS. L. SHERWOOD**  
19 \_\_\_\_\_ Scout

Date JUN 22 1932 **CHAS. L. SHERWOOD**  
192 \_\_\_\_\_ Scout

Harvey

Harvey

43 KANSAS  
Map No. Sec. 20 Twp. 22 R. 3 W

43 KANSAS  
Map No. Sec. 20 Twp. 22 R. 3 W

Well No. 1 Fee

Well No. 1 Fee

F. H. Follow et al Company

F. H. Follow et al Company

Contractor

Contractor

COMPLETED

SECTION PLAT

FIRST REPORTS

SECTION PLAT

Ft. from N. Line  
200 Ft. from S. Line  
Ft. from E. Line  
200 Ft. from W. Line

0			

Ft. from N. Line  
200 Ft. from S. Line  
Ft. from E. Line  
200 Ft. from W. Line

0			
	"OWD"		

Location.....

RECORD

Location.....

RECORD

Rig up.....

Cased in., ft.  
Sand *Hunter 3507-3512*

Rig up.....

Cased in., ft.  
Sand *Hunter 3507-12*

Drilling and Remarks:  
*Flew 1307 Bls  
24 Hours.*

Gas.....  
Oil.....  
Total Depth *3512*

Drilling and Remarks:  
*Old T.D. 3512  
Deepened to 3514 1/2*

Gas.....  
Oil.....  
Total Depth *3514 1/2*

PRODUCTION

1st 24 hrs. Nat.....  
1st 24 hrs. after shot.....  
Gas..... Cu. Ft.  
Dry Hole.....  
Abandoned.....

*Pump 276 Bls  
12 Hours.  
May Deepen*

PRODUCTION

1st 24 hrs. Nat.....  
1st 24 hrs. after shot.....  
Gas..... Cu. Ft.  
Dry Hole.....  
Abandoned.....

Date  
JUL 6 1932 CHAS. L. SHERWOOD  
192 Scout

Date  
AUG 2 1932 CHAS. L. SHERWOOD  
192 Scout

43 KANSAS Harvey  
Map No. Sec. 20 Twp. 22 R. 3<sup>W</sup>

Well No. 1 Fee  
F. H. Fellow Co. Company  
Contractor

COMPLETED

..... Ft. from N. Line  
200 ..... Ft. from S. Line  
..... Ft. from E. Line  
200 ..... Ft. from W. Line

SECTION PLAT

0			

Location.....  
Rig up.....  
Drilling and Remarks:

Pump 500 lbs  
21 Hours.

RECORD

Cased..... in., ..... ft.  
Sand Huntow 3507-14<sup>W</sup>  
Gas.....  
Oil.....  
Total Depth..... 35.14<sup>W</sup>

PRODUCTION

1st 24 hrs. Nat.....  
1st 24 hrs. after shot.....  
Gas..... Cu. Ft.  
Dry Hole.....  
Abandoned.....


Date

AUG 31 1932 CHAS. L. SHERWOOD  
192..... Scout

Harvey  
FORM NO. 1-30-PETROLEUM

Map No. KANSAS Sec. 20 Twp. 22 R. 3<sup>w</sup>  
Well No. 1 - School lot Farm  
J. A. Fellow et al Company


200 Ft. from N. Line  
~~300~~ Ft. from S. Line  
~~300~~ Ft. from E. Line  
200 Ft. from W. Line  
1931

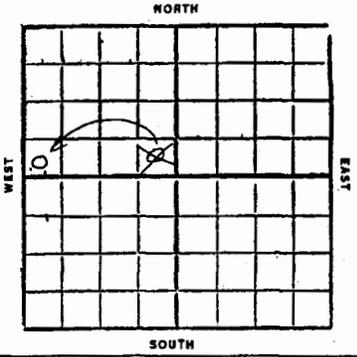

Date	REPORT
3/4	Loc
3/11	Material
3/18	Drain up
3/25	Spud
4/1	Spud 100' & 50'
4/8	
4/15	set 20"-200'
4/22	dreg 770'
4/29	12"-1362
	dreg 1525'
5/6	" 1820'
5/13	U/R 10"-2100'
5/20	U/R 10"-2200'
5/27	Stand 2295-2305' HFW
	8"-2287
	Dreg 2410'
6/3	SD 2410'
6/10	10"-2463
	Dreg 2560'
6/17	SD 2560'
6/24	SD 2700'
7/1	7/8

7/15- SD 2700'  
7/22- HFW 2740-50  
dreg 2785  
7/29- U/R 8"-2860  
8/5- Fsg 2860  
8/12- dreg by tools 2860  
8/19  
8/26- Dreg by tools 2880  
9/2- 8"-2886  
9/9  
9/16- TD 2886' Fishing  
9/23  
9/30  
10/7  
10/14- 6"-2895  
dreg 2900'  
10/21- 6"-2908  
dreg 2930  
10/28- U/R 6"-2949  
11/4- 6"-2964  
Top Chat 3200  
show oil & gas 3204-06  
Rng 5"  
11/10- 5"-3206  
small show oil and  
2 barrel water 3226-30  
Increase oil 3236-41  
HFW at 3270  
TD 3309 To pull 5" & U/R 6"

Map No. Hans Sec. 20 Twp. 22 R. 3w  
 Well No. T-School lot Farm  
J. A. Allow state company

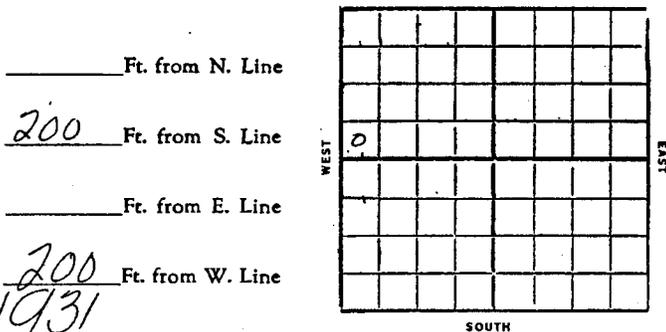


Date	REPORT
11/18	TD 3309 UIR 6"-3100'
11/24	6"-3204
12/2	dreg 3329
12/9	5"-3415'
	dreg 3430'
12/16	Hunton 3507-11 good show free oil UIR 5" csg.
12/18	Shale 3511-14 From 3514-16 filled up 400 ft in 15 minutes Had 2000' oil in 4 hrs
12/22	5"-3507 Oay 3515-17 TD 3517 filled up 2000 ft 4 hr swab & flow 18 bbl for 1 hr for 6 hr SD 3517 4 1/4 gravity


12/30- TD 3517  
flow 120 bbl 24 hrs  
1932  
1/6- TD 3517  
shut in for pipe line  
1/13 —  
1/20 —  
1/27 —  
2/3- Refuse to give information  
2/10- Land 3514-16  
TD 3516  
Pump 114 bbl 5 hr  
shut in  
Comp.  
1932  
OWDD  
6/21- Deepened 3 feet in Hunton  
lime - TD 3512 (steel line  
correction) Flowed 1456 bbls.  
in 25 hours - (Telegram)  
6/22- Old TD 3509 (corrected)  
Top Hunton 3507 (SLM)  
Deepened to  
TD 3512  
flow 1456 bbl 25 hrs  
6/29- TD 3512  
flow 1307 bbl 24 hr  
on June 22<sup>nd</sup>  
7/6- Hunton 3507-12  
TD 3512  
flow 1307 bbl 24 hr  
Comp.

Map No. **KANSAS** Sec. 20 Twp. 22 R. 3w  
Well No. 1 Farm Fee  
J. H. Hollows et al. Company

Ft. from N. Line \_\_\_\_\_  
200 Ft. from S. Line \_\_\_\_\_  
Ft. from E. Line \_\_\_\_\_  
200 Ft. from W. Line \_\_\_\_\_  
1932

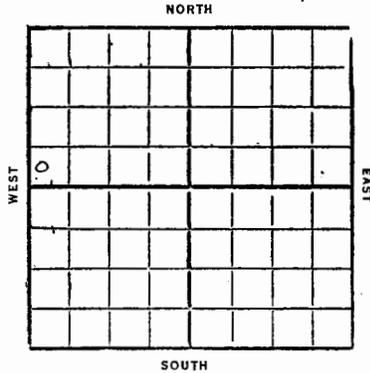

Harvey  
Form 51-5M-1-30-3840  
Map No. **KANSAS** Sec. 20 Twp. 22 R. 3w  
Well No. 1 Farm Fee  
J. H. Hollows et al. Company

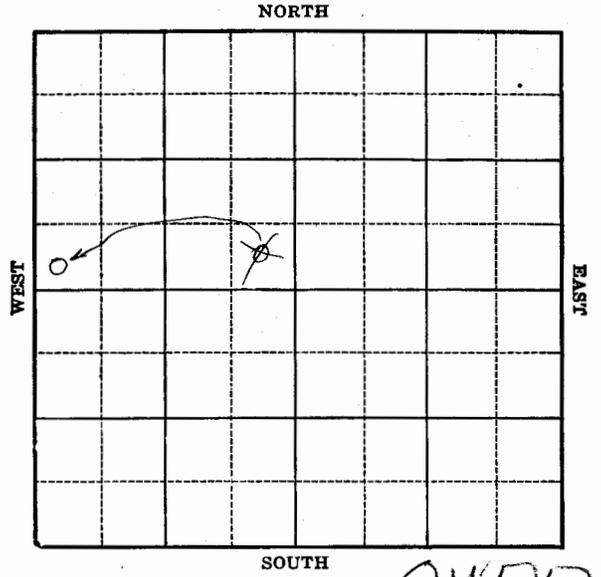

Date 8/24 **OWDD** REPORT

Old TD 3512  
Deepened to  
TD 3514 1/2 Hunton  
Pump 276 bbl 12 hr  
May deepen

8/31 Hunton 3507-14 1/2  
TD 3514 1/2  
Pump 520 bbl 21 hr  
Comp.

Location \_\_\_\_\_  
Drilling Remarks \_\_\_\_\_  
\_\_\_\_\_  
\_\_\_\_\_  
**OWDD**  
Rig Up \_\_\_\_\_  
Drilling Remarks \_\_\_\_\_  
\_\_\_\_\_  
\_\_\_\_\_  
\_\_\_\_\_  
\_\_\_\_\_  
\_\_\_\_\_  
\_\_\_\_\_  
\_\_\_\_\_  
\_\_\_\_\_  
\_\_\_\_\_

**RECORD**  
Cased \_\_\_\_\_ in. \_\_\_\_\_ ft.  
Sand \_\_\_\_\_  
Gas \_\_\_\_\_  
Oil \_\_\_\_\_  
Total Depth \_\_\_\_\_

**PRODUCTION**  
1st 24 hrs. Nat. \_\_\_\_\_  
1st 24 hrs. after shot \_\_\_\_\_  
Gas \_\_\_\_\_ cu. ft.  
Dry Hole \_\_\_\_\_  
Abandoned \_\_\_\_\_