

43 HARVEY
Map No. Sec. 20 Twp. 22 R. 3 W

Well No. 1 Friesen
N. O. Mc Bride, Inc Company
Contractor

SECTION PLAT

4x4 grid with '0' in the second row, first column.

145 Ft. from N. Line
Ft. from S. Line
Ft. from E. Line
200 Ft. from W. Line

Location ✓

RECORD

Cased in. ft.
Sand
Gas
Oil
Total Depth

PRODUCTION

1st 24 hrs. Nat.
1st 24 hrs. after shot
Gas Cu. Ft.
Dry Hole
Abandoned

Date MAR 9 1932

19 Scout

43 HARVEY
Map No. Sec. 20 Twp. 22 R. 3 W

Well No. 1 Friesen
N. O. Mc Bride, Inc Company
Contractor

SECTION PLAT

4x4 grid with '0' in the second row, first column.

145 Ft. from N. Line
Ft. from S. Line
Ft. from E. Line
200 Ft. from W. Line

Location

RECORD

Rig up
Drilling and Remarks:

Cased in. ft.
Sand 3505-15
Gas
Oil
Total Depth 3515

Flow 354 Bl
in 2 Hours.
Shut in to
50 Bls per Day

PRODUCTION

1st 24 hrs. Nat.
1st 24 hrs. after shot
Gas Cu. Ft.
Dry Hole
Abandoned

Date

JUN 29 1932 CHAS. LINERWOOD
192 Scout

Harvey
FORM 252A-BM-8-30-PEWOL

Map No. **KANSAS** Sec. 20 Twp. 22 R. 3^W


Well No. 1 - Trevon Farm
W.C. Mc Bride, Inc Company

145 Ft. from N. Line

_____ Ft. from S. Line

_____ Ft. from E. Line

200 Ft. from W. Line

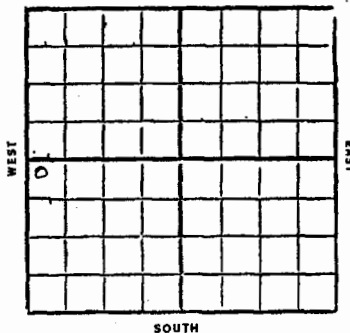

1932

Date	REPORT
3/9	Loc
3/16	Bedg rig
3/22	Ruin tip
3/30	Drilg att 244'
4/6	Drilg 8'70'
4/13	13" 1178
	2 trailer water 1238
	Drilg 1495
4/20	" 1800'
4/27	TD 2275 2 1/2" 10"
5/4	HFW 2339-65
	drilg ahead
5/11	10"-2505
	Drilg 2540'
5/18	8"-2751
	Sandy lime 2800-10' HFW
	drilg 2810'
5/25	8"-2876
	Drilg 2995
6/1	Top chat 3178 3195
	Show oil 3180
	8"-3178' Clg out

- 6/9- Top chat 3195 (corrected)
8" 3199
show oil & gas 3225
Water 3233-38
HFW 3248-60
Drilg 3340'
- 6/15- Base lime 3407
Top Hunton 3505
Rng 6" csg
- 6/22- Top Hunton 3505-13
- 5 h. m. -
flow 357 bbl 3 hr test
" 354 " 2 " "
Graw 44⁵ at 70°
- 6/29- Hunton 3505-13
TD 3513.
flow 354 bbl 2 hrs
pinched to 50 bbl day
Comp.

