

Harvey

W

43 KANSAS Map No. Sec. 20 Twp. 22 R. 3

Well No. 3 Friesaw

N. C. McBride, Inc. Company

Contractor

FIRST REPORTS

SECTION PLAT

990 Ft. from N. Line

Ft. from S. Line

Ft. from E. Line

330 Ft. from W. Line

Section plat grid with handwritten '0' in the bottom-left cell.

Location

Rig up

Drilling and Remarks:

Bleg Rig

RECORD

Cased 8 in., 349 ft.

Sand Hunter 3488-3506

Gas

Oil

Total Depth 3506

PRODUCTION

1st 24 hrs. Nat.

1st 24 hrs. after shot

Gas Cu. Ft.

Dry Hole

Abandoned

Date SEP 21 1932 CHAS. L. SHERWOOD 192 Scout

Harvey

W

43 KANSAS Map No. Sec. 20 Twp. 22 R. 3

Well No. 3 Friesaw

N. C. McBride, Inc. Company

Contractor

SECTION PLAT

990 Ft. from N. Line

Ft. from S. Line

Ft. from E. Line

330 Ft. from W. Line

Section plat grid with handwritten '0' in the bottom-left cell and a small mark in the bottom-right cell.

Location

Rig up

Drilling and Remarks:

Pay 3500-06

Swab East 150 Pts Per Hour. Shut in.

RECORD

Cased 8 in., 349 ft.

Sand Hunter 3488-3506

Gas

Oil

Total Depth 3506

PRODUCTION

1st 24 hrs. Nat.

1st 24 hrs. after shot

Gas Cu. Ft.

Dry Hole

Abandoned

Date NOV 20 1932 CHAS. L. SHERWOOD 192 Scout

Harvey
FORM 252A-SM-9-30-PR-101

Map No. KANSAS Sec. 20 Twp. 22 R. 3^w

Well No. 3-Grison Farm


W.C. Mc Bride, Inc. Company

990 Ft. from N. Line

_____ Ft. from S. Line

_____ Ft. from E. Line

330 Ft. from W. Line

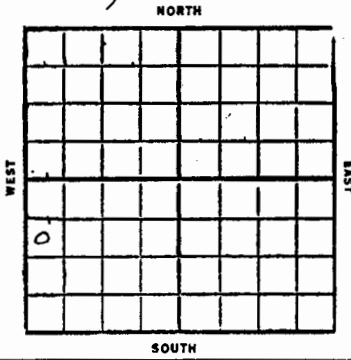

1932

Date REPORT

Date	REPORT
9/21	Bedg rig
9/30	"
10/5	Spdg.
10/12	" 15" 337
	Drig 784
10/19	" 2076
10/26	" 2784'
11/2	Top chat 3175
	show oil 3202
	area 3250'
11/9	Top Hunton 3490 3488
	setg 8"-3491
11/16	Top Hunton 3488
	(corrected)
	Pay 3500-06
	Hole full oil in 45 min
	kill swab
11/23	TD 3506
	swab 65 bbl 1 hr
	(over)

11/30- Cured 8"-3491
 Hunton 3488-3506
 Pay 3500-06
 TD 3506
 swab (est) 150 bbl per hr
 shut in
 Comp.

