

Section 3 Township 22 Range 13 W

Well No. # 1 Gates (A)

Company Petroleum Inc.

NORTH

	0						

WEST

EAST

SOUTH

Sec. 3 Twp. 22 R. 13W

Well No. #4 Gates (A) Farm

Petroleum Inc. Company

Garvie Contractor


990 Ft. from N. Line

\_\_\_\_\_ Ft. from S. Line

\_\_\_\_\_ Ft. from E. Line

990 Ft. from W. Line

SE NW NW

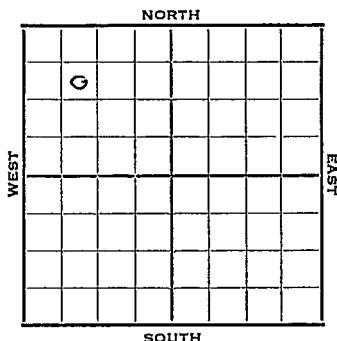

1952

Elev. 1889.5

REPORT

6/25

Spud 6-20-52

8" @ 253'

Anhy 732'

Drlg. 2045'

7/2

Spud 6-20-52

D & A TD 3786' 8" @ 253'

Anhy 732' Heeb 3226' Br. lime 3354'

Lans. 3374' Cong. 3648' Viola 3656'

Simp/ 3718' Arb. 3772'

DST 3773-76 open 20 min, rec 5' mud

DST 3774-81 open 1 hr. rec 15' SOCM

DST 3775-86 open 20 min. rec 8' mud

D & A

**ABANDONED**

County **Stafford** State **Kansas**

Sec. **3** (Blk.) **22** (Sur.) **13<sup>W</sup>** Map No.  
(Twp.) (Rge.)

Operator **Petroleum Inc.**

Well No. **4** Farm **Gates (A)**

Elev. **1889** Location **SE NW NW**


**990** Ft. From **N** Line **NW**

**990** Ft. From **W** Line Quarter

Ist. Report **JUN 25 1952**

Completion

Remarks

**Garvie - Contr.**

Spudding Date **6-20-52**

**FIRST REPORT**

Drlg. Data

**8" @ 253 Anhy 732 Drlg. 2045**

