


KANSAS

Stafford County

• Section 3 Township 22 Range 13W

Well No. #1 G. F. Gates

Company W. P. Faulkner

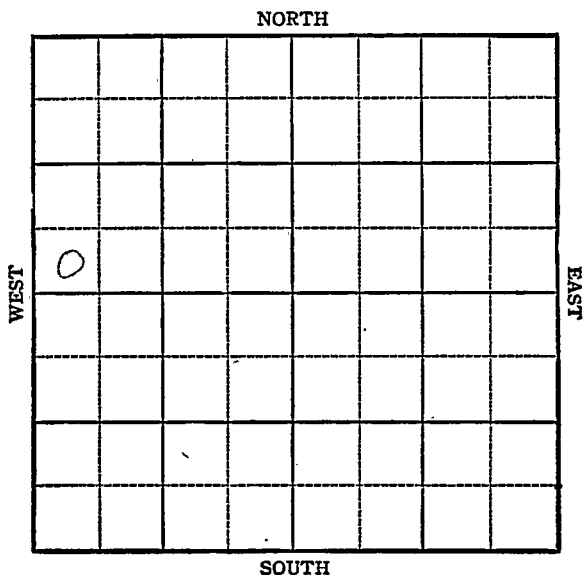

KANSAS

Stafford County

Sec. 3 Twp. 22 R. 13W

Well No. #1 G. F. gates Farm
W. P. Faulkner Company


Drach

 Ft. from N. Line

330 Ft. from S. Line

 Ft. from E. Line

330 Ft. from W. Line

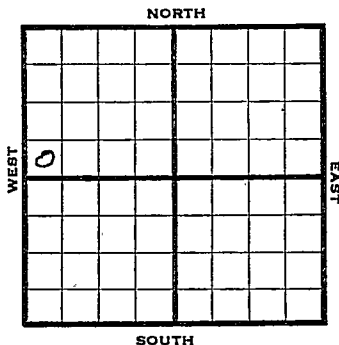

SW NW

R E P O R T

1944

11/15 Location
11/24 8" & 272 Drlg. 892
11/29 Drlg. 2924
12/6 Lans 3392
Drlg. 3590'
12/13 Cong 3650
Viola 3672
Simp 3713
Arb. 3764
TD 3797'

ABANDONED


Pool Name DrachMap No. 82 Sec. 3 Twp. 22 R. 13WWell No. 1 G. F. GatesW. P. Faulkner Company

FIRST REPORT

Contractor

SW NW

SECTION PLAT

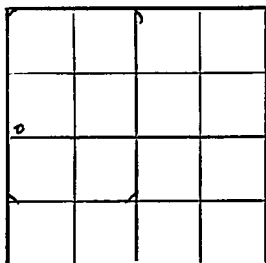 Ft. from N. Line330 Ft. from S. Line Ft. from E. Line330 Ft. from W. LineStafordLocation XRig up

Drilling and Remarks:

RECORD

Cased in., ft.Sand Gas Oil Total Depth

PRODUCTION

1st 24 hrs. Nat. 1st 24 hrs. after shot Gas Cu. Ft.Dry Hole Abandoned

Date

NOV 15 1944

19

S. J. LEWIS

Scout

Pool Name DrachMap No. 82 Sec. 3 Twp. 22 R. 13WWell No. 1 G. F. GatesW. P. Faulkner


Company

ABANDONED

Contractor

SW NW

SECTION PLAT

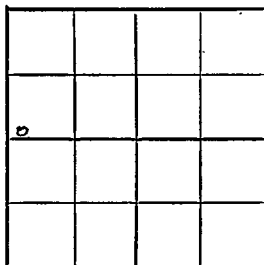 Ft. from N. Line330 Ft. from S. Line Ft. from E. Line330 Ft. from W. LineStaffordLocation Rig up

Drilling and Remarks:

Cong 3650Viola 3672Simp 3713Cer 3764

RECORD

Cased in., ft.Sand Gas Oil Total Depth 3787

PRODUCTION

1st 24 hrs. Nat. 1st 24 hrs. after shot Gas Cu. Ft.Dry Hole Abandoned

Date

DEC 13 194419S. J. LEWIS

Scout