KANSAS


FORM 51 5M PETROL

Stafford

Section 3 Township 22 Range 13-W

Well No. #1 Kisner

Company W. F. Bartlett etal

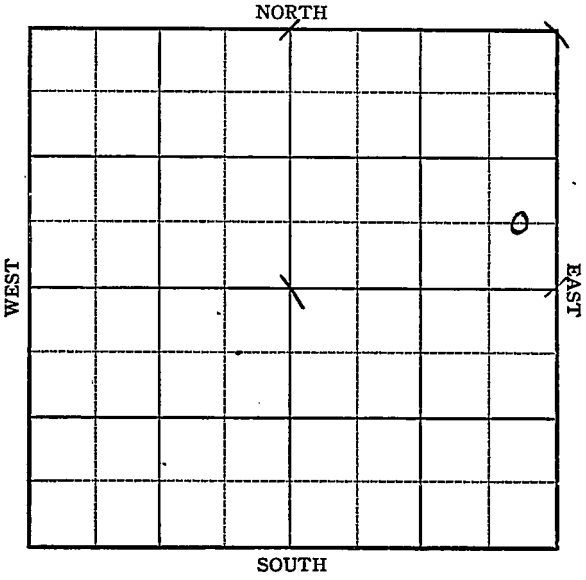

Form 252-A
5M 5-42 Petrol


KANSAS

Stafford

Sec. 3 Twp. 22 R. 13-W

Well No. #1 Kisner Farm

W. N. Bartlett etal Company

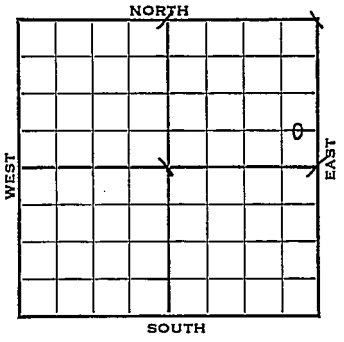

____ Ft. from N. Line

660 Ft. from S. Line

330 Ft. from E. Line

____ Ft. from W. Line

1943	Elev. 1883 REPORT
8/18	Rotary
8/25	"
9/1	8" @ 278 Anhy 720 Drlg. 2000
9/8	Topeka 2910 Drlg. 3036
9/15	Lans 3348 Cong 3590 Viola 3615 Simp 3655 Reword Arb 3698 Drlg. 3703'
9/22	Arb 3723 T.D. 3352 5" @ 3752' Rust
9/29	"
10/6	Plug 3735 w/2 shots 3704-08 12 shots 3707-14 2650' oil in 48 hrs.
10/13	500 acid Temp Pot 148 pump
10/20	" " " " "
10/27	" " " " "
11/3	" " " " "
11/10	" " " "

OVER

1943

11/17 500 acid temp pot 148 pump.

11/24 Pump 70 Oil + 10 water a day

12/1 " " "

12/8 " "

12/15 5" @ 3752
A b 3704
Perf. Arb
500 acid
Pump 20 oil & 10 water Pot
TD 3752
Grav. 41

COMPLETED

Form 26 200 Bks 5-42 Petrol

KANSAS 82

Stafford

Map No. Sec. 3 Twp. 22 R. 13W


Well No. 1 Kisner

W. N Bartlett etal. Company

FIRST REPORT Contractor

C E L SE NE

SECTION PLAT

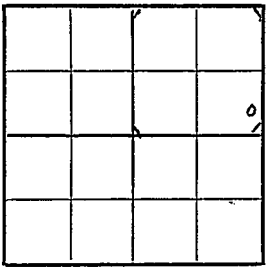

Ft. from N. Line

660 Ft. from S. Line

330 Ft. from E. Line

Ft. from W. Line

Wildcat

Location

Rig up

Drilling and Remarks:

Rotary

RECORD

Cased in., ft.

Sand

Gas

Oil

Total Depth

PRODUCTION

1st 24 hrs. Nat.

1st 24 hrs. after shot

Gas Cu. Ft.

Dry Hole

Abandoned

Date

AUG 18 1943 19

S. J. LEWIS Scout

Form 26 200 Bks. 5-42 Petrol

Stafford

KANSAS

Map No. 82 Sec. 3 Twp. 22 R. 13W


Well No. 1 Kisner

W. N. Bartlett etal. Company

COMPLETED Contractor

C E L SE NE

SECTION PLAT

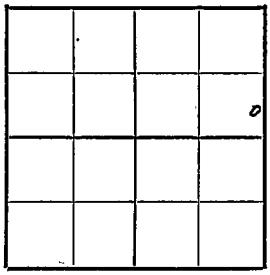

____ Ft. from N. Line

660 Ft. from S. Line

330 Ft. from E. Line

____ Ft. from W. Line

Wildcat

Location

Rig up

Drilling and Remarks:

Cr 3704

5" @ 3752

Perf Rec.

Sooacid

Pump 20 oil + 10 Water

Plug

410 Hr

RECORD

Cased ____ in., ____ ft.

Sand

Gas

Oil

Total Depth 3752

PRODUCTION

1st 24 hrs. Nat.

1st 24 hrs. after shot

Gas ____ Cu. Ft.

Dry Hole

Abandoned

Date

DEC 15 1943 19

S. J. LEWIS Scout