
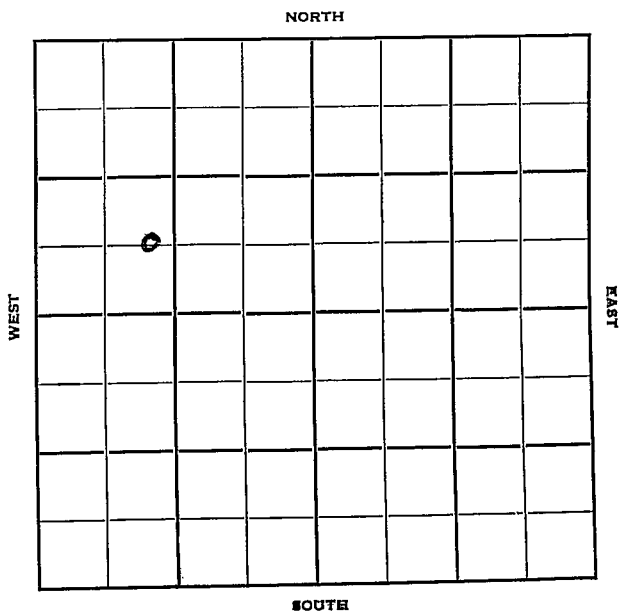


Section 3 Township 22 Range 13 WWell No. # 3 Cates "B"Company Petroleum Inc.

Sec. 3 Twp. 22 R. 13WWell No. #3 Gates "B" Farm __________
Petroleum Inc. Company __________
" Contractor __________
Gates Pool1800 Ft. from N. Line_____
Ft. from S. Line_____
Ft. from E. Line1100 Ft. from W. Line

C E L SW NW

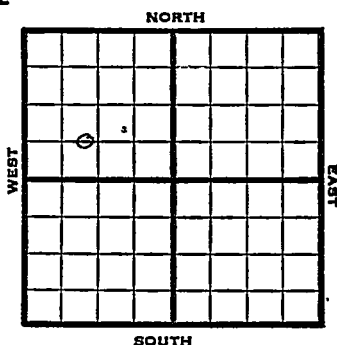

1952 Elev. 1891' REPORT

10/8 Spud 9-30-52

8" @ 244'

Anhy 733'

Drlg. 3350'

10/15 Br L 3349 Heeb 3222, Lans 3369

Arb 3743

TD 3796

5" @ 3795'

10/22 No report

10/29 "

11/5 8/3752-54, 3½ BOPH

900' off Btm

Est 7 BOPH POP

11/12 NR

11/19 Spud 9-30-52

Oil Well

TD 3796'

8" @ 244'

Anhy 733, Br. lime 3349,

Heeb. 3222, Lans 3369

DST 3431-37, opn 1 hr., rec.

55' mud,

DST 3484-3515, opn 1 hr., rec.

12' mud

DST 3542-64, opn 1 hr., rec.

60' ocm, 180' gas 235#

OVER

(Information Brought Forward)

1952

11/19 Arb. 3743

DST 3744-48, opn 20 mins., rec.
7' mud

DST 3745-53, opn 1 hr., rec.
840' oil, 120' gassy oil, 1290#


TD 3796

5" @ 3795

8/3752-54, $3\frac{1}{2}$ boph

Comp. 50 bopd

COMPLETED

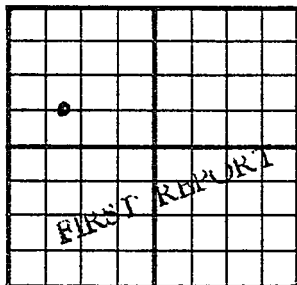County Stafford State KansasSec. 3 (Blk.) 22 (Sur.) 13W Map No.Operator Petroleum Inc.Well No. 3 Farm Gates "B"Elev. 1891 Location C E L SW NW1800 Ft. From N Line NW1100 Ft. From W Line Quarter1st. Report OCT 8 1952

Completion

Remarks

Petroleum Inc. - Contr.Spudding Date 9-30-52Drig. Data Gates Pool8" @ 244 Anhy 733 drlg. 3350

J. G. McGEHEE

County	Stafford		State	Kansas	
Sec.	3	(Blk. Twp.) 2 2	(Sur. Rge.) 13W	Map No.	
Operator	Petroleum Inc.				
Well No.	3	Farm	Gates "B"		
Elev.	1891	Location	C E L SW NW		
			1800 Ft. From	N Line	NW
			1100 Ft. From	W Line	Quarter
			1st. Report		
			Completion NOV 19 1952		
			Remarks Gates Pool		
			Petroleum Inc. - Contr.		
			Spudding Date 9-30-52		

Drlg. Data Oil well TD 3796
 8" @ 244 Anhy 733 Br. lime 3349
 Heeb. 3222 Lans. 3369 DST 3431-37
 open 1 hr. Rec. 55' mud DST 3484-3515
 open 1 hr. Rec. 12' mud DST 3542-64
 open 1 hr. Rec. 60' ocm 180' gas
 235# Arb. 3743 DST 3744-48 open 20 min
 Rec. 7' mud DST 3745-53 open 1 hr.
 Rec. 840' oil 120' gassy oil 1290#
 TD 3796 5" @ 3795 8/ 3752-54 $3\frac{1}{2}$ boph
 Comp. 50 bopd

J. G. McGEHEE