


Section 3 Township 22 Range 13W

Well No. 4 Gates "B"

Company Petroleum Inc.

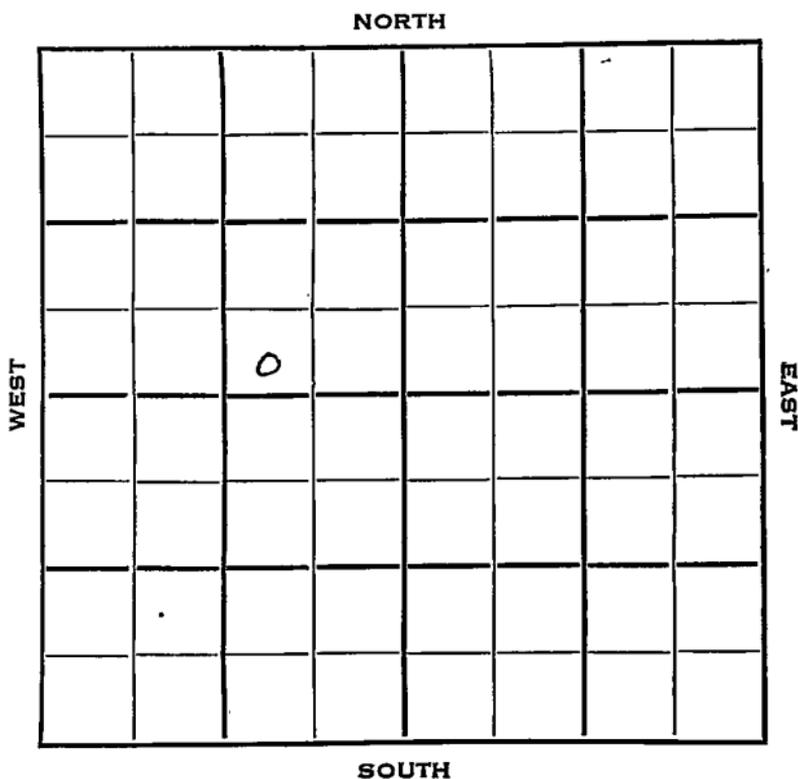

Stafford

Sec. 3 Twp. 22 R. 13WWell No. 4 Gates "B" FarmPetroleum Inc. Company


Contractor

Ft. from N. Line

330 Ft. from S. Line1100 Ft. from E. Line

Ft. from W. Line

SW SE NW

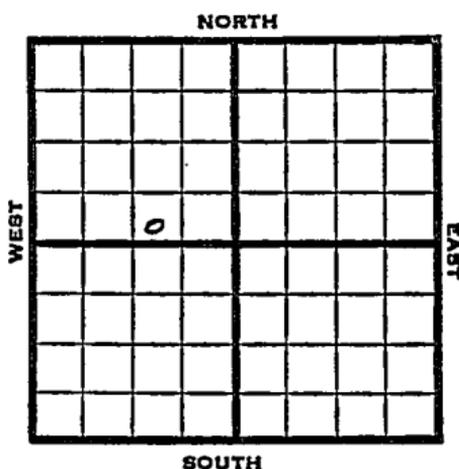

1953 Elev. 1891 REPORT

1/7 Spudding 12/27/52
 8" @ 248 Heeb. 3225 Br. Lim@ 3353
 Lans. 3371 DST 3494-3547 open 3/4 hr.
 Rec. 15' mud 0# Viola 3651 Simp 3706
 DST 3668-3708 open 1 hr. Rec. 30' Mud
 0# Arb. 3755 DST 3756-59 open 40 min.
 Rec. 8' mud 60# DST 3757-64

1/14 Spud 12-27-52.
 D&A TD 3774
 8" @ 248
 Heeb 3225, Br lime 3353, Lans
 3371
 DST 3494-3547, opn 3/4 hrs.,
 rec. 15' mud 0#
 Viola 3651, Simp 3706,
 DST 3668-3708, opn 1 hr., rec.
 30' mud 0#
 Arb. 3755
 DST 3756-59, opn 40 mins., rec.
 8' mud, 60#
 DST 3757-64, opn 3/4 hrs., rec.
 30' ocm
 DST 3758-69, opn 1 hr., rec.
 570' gas, 90' hocm, 180#
 DST 3759-74, -opn 1 hr., rec.
 70' ocm, 130#
 TD 3774
 D&A

ABANDONED

