


DX 78-1

Stafford KANSAS

Section 3 Township 22 Range 11W

Well No. 1 Curtis

Company Petroleum, Inc.

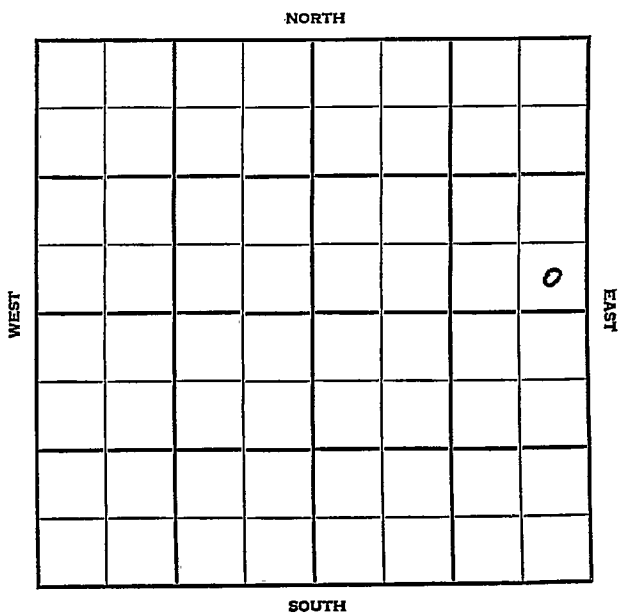

Stafford

KANSAS

SEC.	TWP.	R.
3	22	11W


WELL NO. #1 Curtis FARM

COMPANY Petroleum Inc.

CONTRACTOR Garvey

Smallwood Pool

_____ Ft. from N. Line
 330 _____ Ft. from S. Line
 330 _____ Ft. from E. Line
 _____ Ft. from W. Line

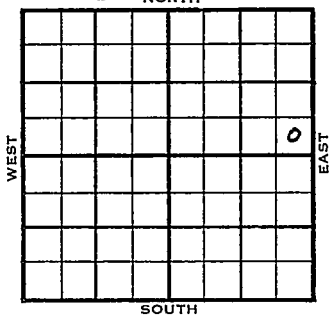

SE SE NE

	ELEVATION	REPORT
1954	1939'	
12/15	Spud 12-12-54 8" @ 221' Drlg. 1625'	
1955 2/9	Spud 12-12-54 - Oil Well TD 3825' 8" @ 221' Anhy 830', Heeb. 3306', Br lime 3430', KC 3440' DST 3556-71', opn 1 hr., rec. 80' vhocm, 180' clean oil, 700# DST 3617-30, opn 1 hr., gas in 5", rec. 330' free oil, 120' froggy oil, 30' SW, 250# DST 3650-68', opn 1/2 hr., rec. 10' mud, 0# Cong. 3706', Viola 3737', Simp. 3754', Arb. 3797' TD 3825' 4" @ 3825' 24/3626-32, 500A, S/12 bfph 16% wtr. 2000A, S/16 bfph 25% wtr., SP 3580 16/3565-69, 1 go 1 gwph, 500A 16 boph Comp. 366 bopd 10% wtr.	

