


Section 3 Township 22 Range 11W

Well No. #1 Adams

Company Trans-Era & Harris & Suppes

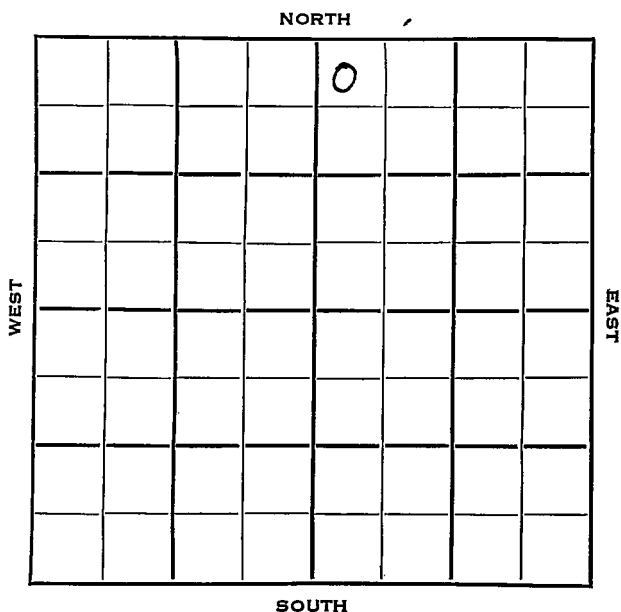

NOT FILE

Stafford KANSAS



Sec. 3 Twp. 22 R. 14 W

Well No. # 1 Adams Farm

Trans-Era & Harris & Suppes Company


Trans-Era Contractor

330 Ft. from N. Line

Ft. from S. Line

Ft. from E. Line

330 Ft. from W. Line

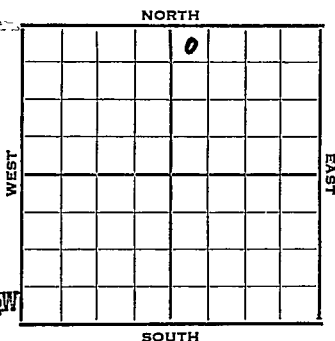

NW NW NE
MCPC has SW of 33-21-14W
Phillips Farmout.

Elev. 1941' REPORT

1953

7/22

Spud 7-18-53
8" @ 263 WOC

7/30

Heeb 3299 Lans 3428
Drlg. 3509' (Ltr-McGehee)

8/6

DST 3567-95', open 1 hr rec 15' mud,
1025# Viola 3699 Arb. 3798'
TD 3835' Ran Schl. D & A. (Ltr-McGeh)

8/5

Spud 7-18-53
D & A
TD 3835'
8" @ 263'
Heeb 3299, Lans 3428,
DST 3567-95 opn 1 hr, rec 15' mud,
1025# Viola 3600, Arb 3798
TD 3835'
D & A

ABANDONED

3798
1941
1857

County **Stafford** State **Kansas**

Sec. **3** (Blk. **22** (Sur. **14W** Map No.

Operator **Trans-Era & Harris & Suppes**

Well No. **1** Farm **Adams**

Elev.	Location	NW	NW	NE
-------	----------	----	----	----

0

FIRST REPORT

330 Ft. From N Line NE

330	Ft. From	W Line	Quarter
-----	----------	--------	---------

1st. Report JUL 22 1953

Completion _____.

Remarks Phillips farmout

Trans-Era - Contr.

Spudding Date 7-18-53

Drig. Data MCPC has SW of 33-21-14W

8th @ 263 WOC

J. G. McGEHEE

County Stafford State Kansas
 Sec. 3 (Blk.) 22 (Sur.) 14W Map No. _____
 Operator Trans-Era & Harris & Suppes
 Well No. 1 Farm Adams
 Elev. 1941 Location NWNW NE

				0			

330 Ft. From N Line NE

330 Ft. From W Line Quarter

1st. Report _____

Completion 406 5 1953

Remarks _____

Trans-Era - Contr.

Spudding Date 7-18-53

Drlg. Data D & A TD 3835

8" @263 Heeb. 3299 Lans. 3428

DST 3567-95 open 1 hr. Rec. 15' mud

1025# Viola 3699 Arb. 3798 TD 3835

D & A