


Section 3 Township 22 S Range 14 W

Well No. #1 Garvin "A"

Company Petroleum, Inc.

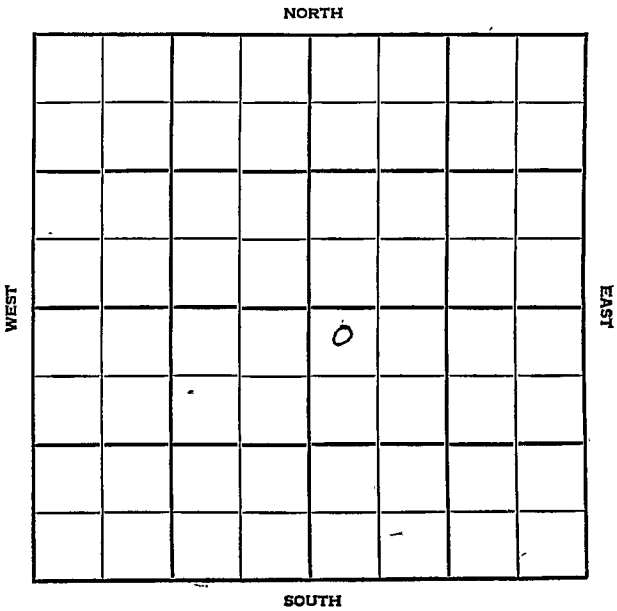

STAFFORD

KANSAS

SEC.	TWP.	R.
3	22S	11W

WELL NO.

#1 Garvin "A"

FARM

COMPANY

PETROLEUM INC.

CONTRACTOR

Garvey  
Hickman So.


\_\_\_\_\_ Ft. from N. Line

\_\_\_\_\_ Ft. from S. Line

\_\_\_\_\_ Ft. from E. Line

\_\_\_\_\_ Ft. from W. Line

NW NW SE

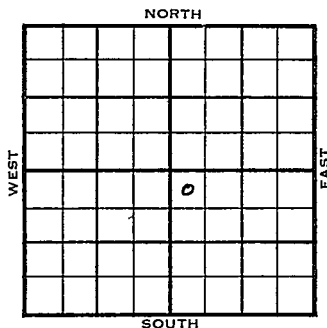

Amerada - DHM

1955	ELEVATION	REPORT
	1941'	

9/21

MIRT

10/5

Comm 2-20-55

8 5/8" @ 226/200

H 3304

B1 3424

L 3434

C 3700

V 3718

S 3763

A 3793

TD 3818

DST 3435-3512 open 1 hr Rec 165'

wm 1050/30# m DST 3549-68 open 1 hr

Rec 25' mud 800# DST 3615-28 open

1 hr Rec 35' ocm 150#

D &amp; A

**ABANDONED**

 Sec. 3 Twp. 22S Rge. 14W  
 Company Petroleum, Inc.  
 FarmName Garvin "A" No. 1

TOPS	DEPTH.	LOG	DATUM
Anh.			
Tp.			
H.			
Tr.			
Dg.			
Bl.			
L.			
K.C.			
B.K.C.			
Ce.			
C.			
M.			
N.			
K.			
Mz.			
Me.			
V.			
S.			
S.			
A.			
R.			
PE.			
G.			
T.D.			

Loc. in Sec. NW NW SE  
Amerada - DHM  
 Geol. \_\_\_\_\_  
 Contr. \_\_\_\_\_  
Garvey #3  
 Pool \_\_\_\_\_  
Hickman So.


FIRST REPORT

Date Comm. WIRP SEP 21 1955

*(Large handwritten scribble)*

Co.  
Lse.  
No.  
Sec.  
T.  
R.

County Stanford Elev. 1941  
 Sec. 3 Twp. 22 Rge. 14W  
 Company Petroleum Inc.  
 FarmName Garvin "A" No. 1

TOPS	DEPTH	LOG	DATUM	Loc. in Sec.
Anh.				NW NW SE
TP.				
H.	<u>3304</u>		<u>1363</u>	
Tr.				
Dg.				
Bl.	<u>3424</u>		<u>1483</u>	
L.	<u>3434</u>		<u>1493</u>	Geol.
K.C.				Contr.
B.K.C.				
Ce.				
C.	<u>3700</u>		<u>1759</u>	Garvey
M.				Pool
M.				
K.				S. Hickman
Mz.				
Ma.				
V.	<u>3718</u>		<u>1777</u>	<b>ABANDONED</b>
S.	<u>3763</u>		<u>1822</u>	
S.				
A.	<u>3793</u>		<u>1852</u>	
R.				
PE.				
G.				
TR.	<u>3818</u>			

Date Comm. 9-20-55 **OCT** 5 1955  
8 5/8" @ 226/200 DST 3435-3512 open 1 hr  
Rec. 165' wm 1050/30" DST 3549-68  
open 1 hr. Rec. 25' mud 800#  
DST 3615-28 open 1. hr. Rec. 35' ocm  
150#

D & A

Co.  
Lse.  
No.  
Sea  
T.  
R.