

Section 3 Township 22 Range 16W

Well No. #4 Baldwin "A"

Company Musgrove Pet.

NORTH

	0						

WEST

EAST

SOUTH

SEC.	TWP.	R.
3	22	16W

WELL NO. \_\_\_\_\_

#4 Baldwin "A" FARM

COMPANY \_\_\_\_\_

Musgrove Pet.

CONTRACTOR \_\_\_\_\_

Musgrove


Larned Pool

330 \_\_\_\_\_ Ft. from N. Line

\_\_\_\_\_ Ft. from S. Line

\_\_\_\_\_ Ft. from E. Line

990 \_\_\_\_\_ Ft. from W. Line

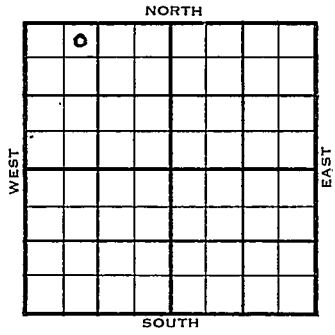

NE NW NW

1953	ELEVATION	REPORT
	1989'	

9/23 Spud 9-15-53  
8" @ 973'  
Drlg 3120'

9/30 Heeb 3397' Tor 3413' Br li 3503'  
Lans 3513' B KC 3736' Cong 3828'  
Arb. 3871' RTD 3874' 5" @ 3872

10/7 C.O.

10/21 Spud 9-15-53 D & A TD 3914  
8" @ 973 Heeb 3397 Tor. 3413  
Br lime 3503 Lans 3513 B KC 3736  
Cong 3828 Arb. 3871 TD 3874  
5" @ 3872 CO 3874 DD 3875 250 A  
1 GO 4 GWPH 16 hr. 6/3871-72  
6/3872-73 4 BW A-frac. S/1.67 BFPH  
75% wtr. DD 3914 FU 2000' wtr.  
S/12 BWPH D & A

**ABANDONED**

*Handwritten:*  
3513  
1989  
-----  
1882

*Handwritten:*  
357  
3513  
-----  
358

County Pawnee State Kansas

Sec. 3 (Blk. 22 (Sur. 16W Map No. 22) (Twp.)

Operator Musgrove Pet.

Well No. 4 Farm Baldwin "A"

Elev. 1989 Location NE NW NW

0					

330 Ft. From N Line NW

990 Ft. From W Line Quarter

Ist. Report SEP 23 1953

Completion \_\_\_\_\_

Remarks \_\_\_\_\_

Musgrove - Contr.

Spudding Date 9-15-53

Drlg. Data Earned Pool

8" @ 973 drlg. 3120

County Pawnee State Kansas

Sec. 3 (Blk. Twp.) 22 (Sur. Rge.) 16W Map No.

Operator Musgrove Pet.

Well No. 4 Farm Baldwin "A"

Elev. 1989 Location NE NW NW

o				

330 Ft. From N Line NW

990 Ft. From W Line Quarter

1st. Report

Completion OCT 21 1953

Remarks Larned Pool

Musgrove - Contr.

Spudding Date 9-15-53

Drlg. Data D & A TD 3914

8" @ 973 Heeb. 3397 Tor. 3413

Br. lime 3503 Lans. 3513 B KC 3736

Cong. 3828 Arb. 3871 TD 3874

5" @ 3872 CO 3874 DD 3875 250 A

1 go 4 gwph 16 hr. 6/ 3871-72

6/ 3872-73 4 bw A-frac S/ 1.67 bfph

75% wtr. DD 3914 FU 2000' wtr.

S/ 12 bwph

D & A

J. G. McGEHEE