


Section 3 Township 22 Range 16 W

Well No. # 1 Buster

Company Vickers Exploration Ltd.

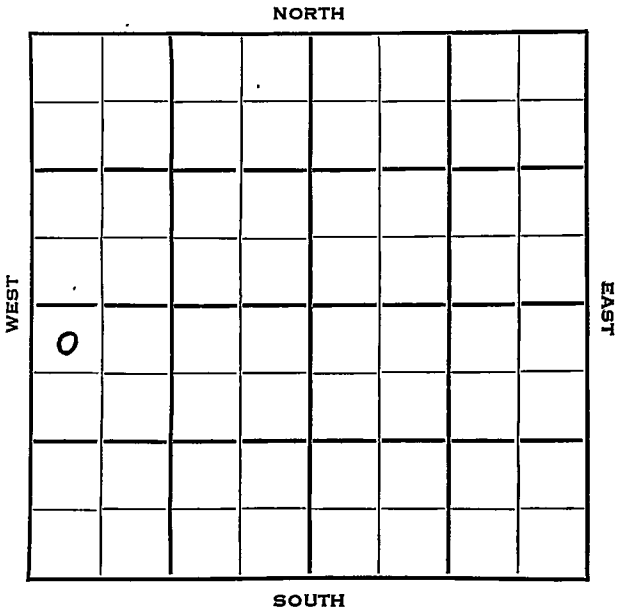

Pawnee

KANSAS

Sec. 3 Twp. 22 R. 16WWell No. #1 Bunter FarmVickers Exploration Ltd. CompanyJayhawk Drlg. Contractor

Wildcat.


330 Ft. from N. Line

Ft. from S. Line

Ft. from E. Line

330 Ft. from W. Line

NW NW SW

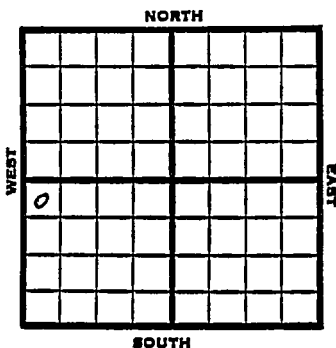

1953

Elev. 1995' REPORT

6/3

M I R

6/10

8" @ 986 Anhy 983

Drlg. 2380

6/24

Spud 6-3-53 D & A TD 3967

8" @ 986 Anhy 983 Br line 3516

Lans 3527 Viola 3839 Simp 3876

Arb. 3939

DST 3941-52 open 1 hr rec 15' mud Off

TD 3967


D & A

ABANDONED

$$\begin{array}{r} 3939 \\ 3527 \\ \hline 412 \end{array}$$

$$\begin{array}{r} 3939 \\ 1995 \\ \hline 1944 \end{array}$$

County Pawnee State Kansas
 Sec. 3 (Blk.) 22 (Sur.) 16W Map No.
 (Twp.)
 Operator Vickers Exploration, Ltd.
 Well No. 7 Farm Buster
 Elev. _____ Location NW NW SW

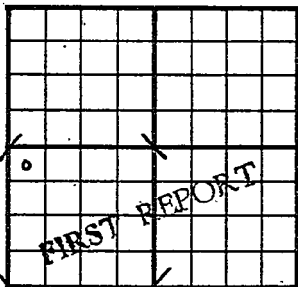


330 Ft. From N Line SW
330 Ft. From W Line Quarter
 1st. Report JUN 3 1953
 Completion _____
 Remarks _____
Jayhawk Drlg. - Contr.
 Spudding Date _____

Drlg. Data Wildcat

M I R

County Pawnee State Kansas
 Sec. 3 (Blk. 22 (Sur. 16W Map No.)
 Operator Vickers Exploration, Ltd.
 Well No. 1 Farm Buster
 Elev. 1995 Location NW NW SW

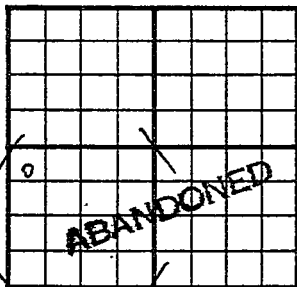

330 Ft. From N Line SW
330 Ft. From W Line Quarter

1st. Report

Completion JUN 24 1953

Remarks Wildcat

Jayhawk Drlg. - Contr.

Spudding Date 6-3-53

Drlg. Data D & A TD 3967

8" @ 986 Anhy 983 Br. lime 3516

Lens. 3527 Viola 3839 Simp. 3876

Arb. 3939 DST 3941-52 open 1 hr.

Rec. 15' mud O# TD 3967

D & A

J. G. McGEHEE