


Section 3 Township 22 Range 16 W

Well No. # 1 Buster

Company Davis-Childs-F. Nixon & Sterling Drilg.

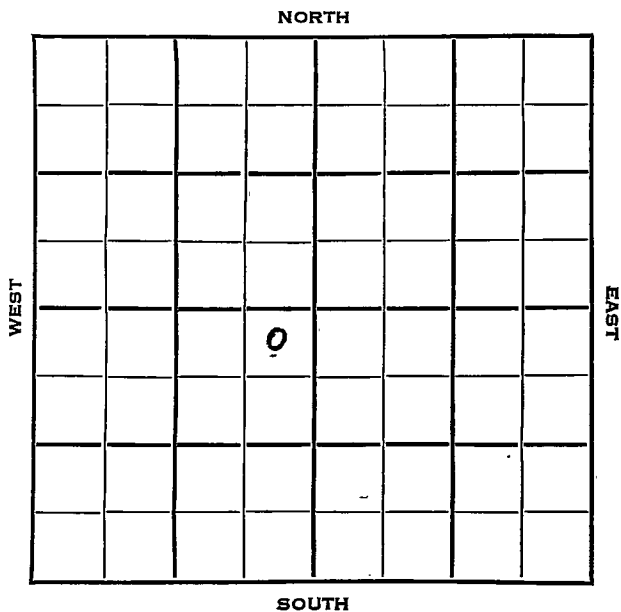

Pawnee

KANSAS

SEC.	TWP.	R.
3	22	16 W

WELL NO.

1 Byster FARM

COMPANY Davis-Childs-F.Nixon & Sterling Drlg.

CONTRACTOR Sterling Drlg.


330 Ft. from N. Line

Ft. from S. Line

330 Ft. from E. Line

Ft. from W. Line

NE NE SW

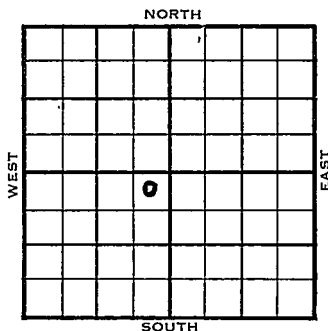

1953	ELEVATION 2000'	REPORT
------	-----------------	--------

10/14 MIR

10/21 8" @ 1005'
Anhy 1000'
Drlg 3105'

10/28 Spud 10-12-53 D & A TD 4065'
8" @ 1005 Anhy 1000 Heeb 3436
Tor. 3453 Doug. 3469 Br line 3540
Lans. 3551 Cong. 3874 Viola 3888
Simp. 3947 Arb. 4032'
TD 4065' D & A

ABANDONED

4032
"

4032
3551
- 481

County Pawnee State Kansas

Sec. 3 (Blk.) 22 (Sur.) 16W (Twp.) 16W Map No.

Operator Davis-Mills-F. Nixon & Sterling Drlg.

Well No. 1 Farm Buster

Elev. _____ Location NE NE SW

FIRST REPORT					

330 Ft. From N Line SW

330 Ft. From E Line Quarter

Ist. Report OCT 14 1953

Completion _____

Remarks _____

Sterling Drlg. - Contr.

Spudding Date _____

Drlg. Data _____

M T R

County Pawnee State Kansas

Sec. 3 (Blk.) 22 (Sur.) 16W Map No.

Operator Davis-Childs, F. Nixon & Sterling Dr

Well No. 1 Farm Buster

Elev. 2000 Location NE NE SW

ABANDONED					
		o			

330 Ft. From N Line SW

330 Ft. From E Line Quarter

Ist. Report

OCT 28 1953

Completion

Remarks

Sterling Drlg. - Contr.

Spudding Date 10-12-53

Drlg. Data D & A TD 4065

8" @ 1005 Anhy 1000 Heeb. 3436

Tor. 3453 Doug. 3469 Br. lime 3540

Lans. 3551 Cong. 3874 Viola 3888

Simp. 3947 Arb. 4032 TD 4065

D & A