

Rice


KANSAS

FORM 51

Section 8 Township 22 Range 8W

Well No. #1 S. Mayer "B"

Company Tom Allan

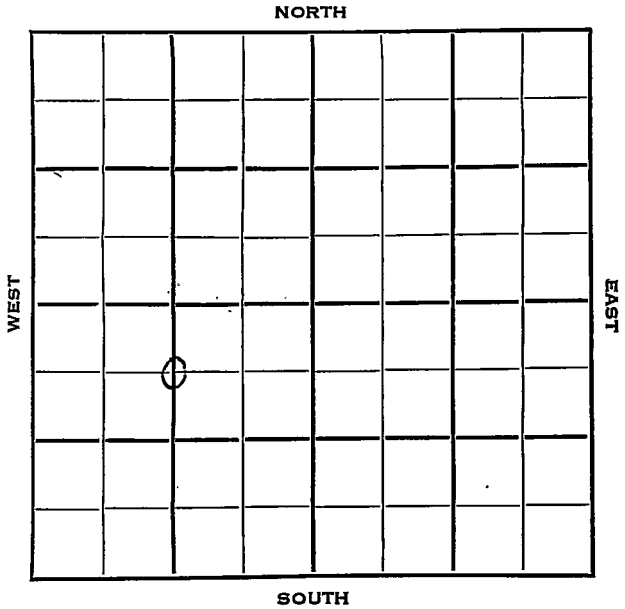

Rice KANSAS

SEC.	TWP.	R.
3	22	8W

WELL NO. **1 S. Mayer "B"** FARM

COMPANY **Tom Allan**

CONTRACTOR **Tom Allan**


**Sterling Pool**

660 Ft. from N. Line

\_\_\_\_\_ Ft. from S. Line

\_\_\_\_\_ Ft. from E. Line

1320 Ft. from W. Line

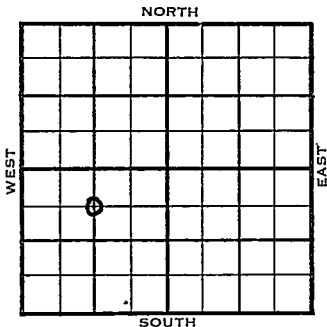

C N/2 SW

	ELEVATION	REPORT
1954	1628'	

- 1/20 Spud 1-18-54  
8" @ 200', WOC
- 2/3 Br. L. 2938', Lans 2963', Miss 3344'  
RTD 3347'  
5" @ 3347'
- 2/10 - Spud 1-18-54  
Oil Well  
TD 3357'  
8" @ 200'  
Br. Lime 2938', Lans 2963', Miss 3344'  
TD 3347'  
5" @ 3347'  
DD 3357'  
VSSG frac. F/ 30 bopd  
Comp.

**COMPLETED**

County **Rice** State **Kansas**

Sec. **3** (Blk. Twp.) **22** (Sur. Rge.) **8W** Map No.

Operator **Tom Allan**

Well No. **1** Farm **S. Mayer "B"**

Elev. Location **C N $\frac{1}{2}$  SW**


**660** Ft. From **N** Line **SW**:

**1320** Ft. From **W** Line Quarter

Ist. Report **JAN 20 1954**

Completion

Remarks

**Tom Allan - Contr.**

Spudding Date **1-18-54**

Drlg. Data **Sterling Pool**

**8" @ 200 WOO**

