


Section 3 Township 22 Range 12W

Well No. #1 Krankenberg

Company A. S. Ritchie et al

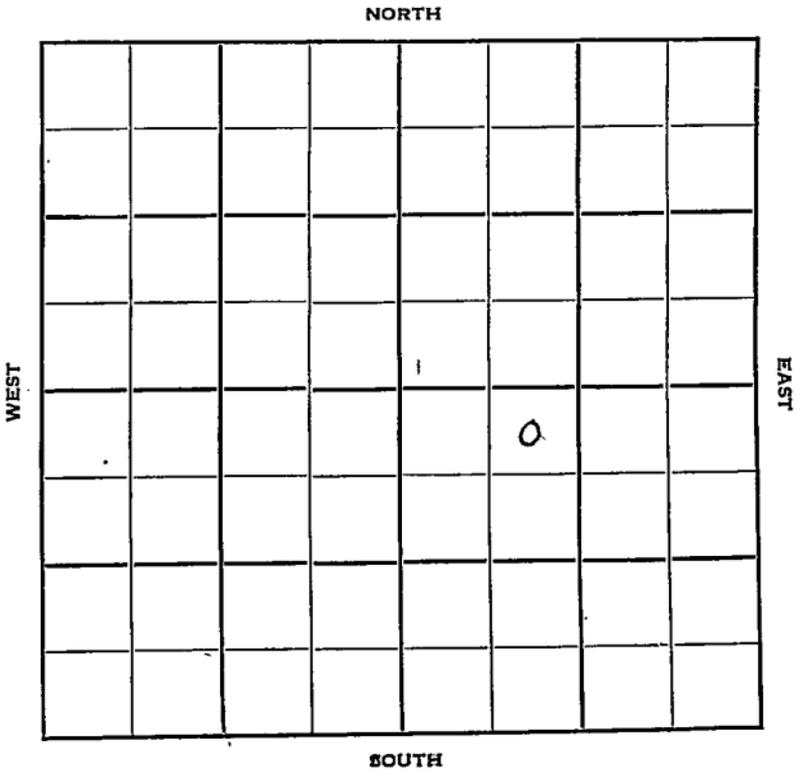

Stafford

Sec. 3 Twp. 22 R. 12W

Well No. #1 Krankenberg Farm

A. S. Ritchie et al Company

Derby Drlg. Contractor

Sittner Pool


330' Ft. from N. Line

_____ Ft. from S. Line

_____ Ft. from E. Line

990' Ft. from W. Line

NE NW SE

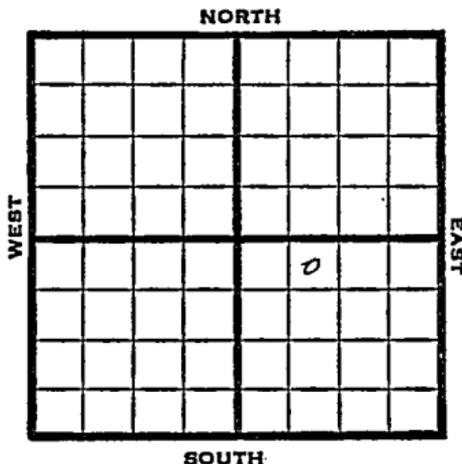

1950 Elev. 1846' REPORT

4/26 Drlg.
 8/2 8" @ 251
 Anhy 626 Br lime 3252
 Lans 3272 Viola 3519
 Simp 3546 Arb 3602
 5" @ 3602
 TD 3604
 FU 1500' oil
 Comp 75 bopd 20% wtr
 Completed

COMPLETED

Kansas

Sittner Pool

Map No. _____ Sec. 3 Twp. 22 R. 12WWell No. 1 KrankenbergA. S. Ritchie et al. CompanyDerby Drls. Contractor

NE NW SE

E 1. 1846
SECTION PLAT330 Ft. from N. Line

_____ Ft. from S. Line

_____ Ft. from E. Line

990 Ft. from W. LineStafford CountyStanolind farmout

Location _____

Rig up _____

Drilling and Remarks:

drlg.

RECORD

Cased _____ in., _____ ft.

Sand _____

Gas _____

Oil _____

Total Depth _____

PRODUCTION

1st 24 hrs. Nat. _____

1st 24 hrs. after shot _____

Gas _____ Cu. Ft.

Dry Hole _____

Abandoned _____

Date

APR 26 1950 19J. E. TYRA Scout

County Stafford State Kansas

Sec. 3 (Blk. 22 (Sur. 12W Map No. (Twp.))

Operator A. S. Ritchie et al.

Well No. 1 Farm Krankenber

Elev. 1846 Location NE NW SE

330 Ft. From N Line SE

990 Ft. From W Line Quarter

Ist. Report

Completion AUG 2 1950

Remarks

Stanolind farmout

Spudding Date

Drlg. Data Sittner Pool

8" @ 251 Anhy 626 Br. line 3252

Lans. 3272 Viola 3519 Simp. 3546

Arb. 3602 5" @ 3602 TD 3604 FU 1500' oi

Comp. 75 bopd 20% water