

Stafford

KANSAS


Form 51-5M-11-38-Palace

Section 3 Township 22 Range 12-W

Well No. #2 Max Sittner

Company Stanolind

NORTH Sittner South Pool

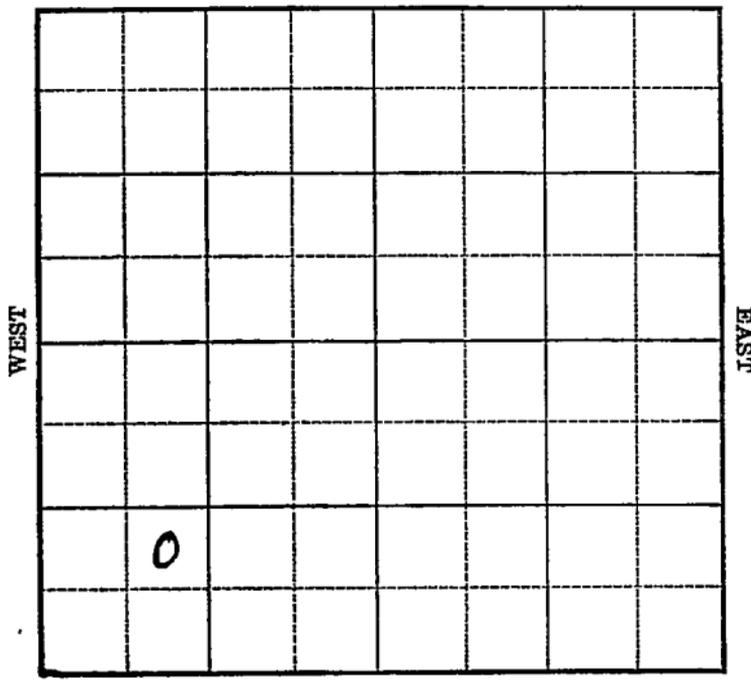

SOUTH

KANSAS

Stafford

Map No. _____ Sec. **3** Twp. **22** R. **12W**

Well No. **2 Max Sittner**

Stanolind

Company

Contractor

**FIRST REPORT
NE SW SW**

SECTION PLAT

_____ Ft. from N. Line

990 Ft. from S. Line

_____ Ft. from E. Line

990 Ft. from W. Line

SITTNER SOUTH POOL

Location **X**

RECORD

Rig up _____

Drilling and Remarks: _____

Cased _____ in., _____ ft.

Sand _____

Gas _____

Oil _____

Total Depth _____

PRODUCTION

1st 24 hrs. Nat. _____

1st 24 hrs. after shot _____

Gas _____ Cu. Ft.

Dry Hole _____

Abandoned _____

Date

JUN 7 1939 19

S. J. LEWIS

Scout

Map No. 46 Sec. 3 Twp. 22 R. 12W

Well No. 2 Max Sittner

Stanolind

Company

Contractor

COMPLETED

NE SW SW

_____ Ft. from N. Line

990 Ft. from S. Line

_____ Ft. from E. Line

990 Ft. from W. Line

SECTION PLAT

SITTNER SOUTH POOL

Location _____

Rig up _____

Drilling and Remarks:

*Per 3630
5" @ 3631
1500 @ and*

Per 399 pump

RECORD

Cased _____ in., _____ ft.

Sand _____

Gas _____

Oil _____

Total Depth 3635

PRODUCTION

1st 24 hrs. Nat. _____

1st 24 hrs. after shot _____

Gas _____ Cu. Ft.

Dry Hole _____

Abandoned _____

Date

JUL 12 1939₁₉

S. J. LEWIS

Scout