

Pawnee


KANSAS

SECTION 3 TOWNSHIP 22 RANGE 20 W

WELL NO. #1 College

COMPANY Vickers Pet.

NORTH

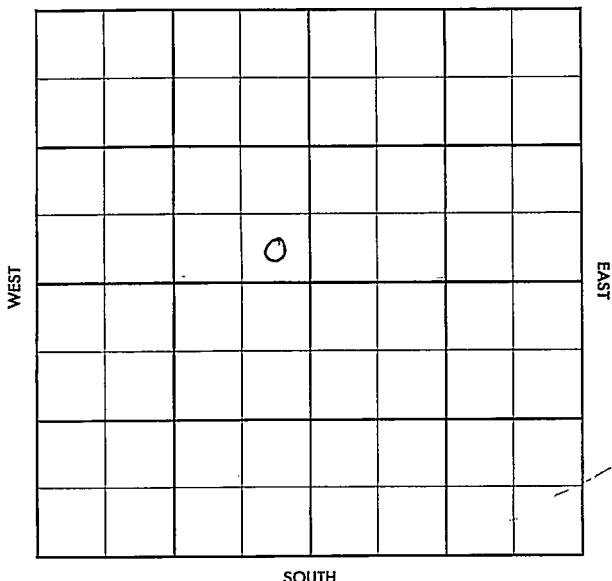

SEC. 3	TWP. 22 S	R. 20 W
---------------	------------------	----------------

#1 College	FARM
------------	------

Vickers Petroleum Company

CONTRACTOR **Harms-Burt**


Wildcat

_____ Ft. from N. Line

_____ Ft. from S. Line

_____ Ft. from E. Line

_____ Ft. from W. Line

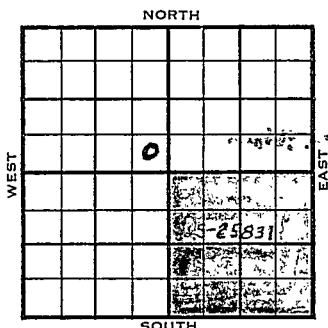

SE SE NW
SDX DHC \$3,000.00
Lse. (S-25831)
Champlin - DHM

DATE	ELEVATION	REPORT	(WH5-DC81)
1955	2161' RB.		
	2158' DE		
9-22	(See DHC Ltr. 9-21-55) (Accepted)		
10/4	DHC Agmt. accepted 9-30-55 (Ltr 10/4/55)		
11/2	Comm. 10-27-55 8" @ 587/400 Drlg. 2210' (F.R. Tkt)		
11-10	Anhy 1295 Ft. Riley 2200 Heeb 3723 Tor 3740 Doug. 3756 Lans. 3796 Testing Miss. chat 4362-70 Good odor, some free oil		
11/16	Comm. 10-27-55 8" @587/400 DST 4362-70 open 1½ hr, rec 30' mud. 550#. DST 4362-85 open 1 hr rec 35' mud. 1135/60". TD 4771' D & A Tops: Anh. 1295', Ft. Riley 2200', H. 3723', Tr. 3740', Dg 3756', L. 3796 M. 4359', Kh sd. 4428', Dolo 4473', Sh 4673', Sd 4686', Arb. 4739', TD 4771'		

OVER

1955

11/16 (Information continued)

Log: H. 3723', L. 3792', M. 4354';
Sh 4415', Kh sd 4423', dolo 4464',
~~sk~~ sd 4680', Arb. 4734' TD 4768'
Total Depth 4771' D & A

ABANDONED

11/25 Advised Contract Section - D & A

County Panther Elev. _____
 Sec. 3 Twp. 22 Rge. 20W
 Company Vickers Pet.
 Farm Name College No. 1

TOPS	DEPTH	LOG	DATUM	Loc. in Sec. _____
Anh.				SE SE NW
Ip.				
H.				
Tr.				
Dg.				
Bl.				
L.				Geol. _____
K.C.				Contr. _____
B.K.C.				Harms-Burt
Ce.				Pool _____
C.				Wildcat
M.				
M.				
K.				
Mz.				
Mq.				
V.				
S.				
S.				
A.				
R.				
Pe.				
G.				
T.D.				

Date Comm. 10-27-55 Sunray MCOC & Champ. DFM
 8th @ 587/100 drlg. 2210

NOV 2 1955
0
FIRST REPORT

2 161 RR

2158 DF

County Pawnee

Elev.

Sec. 3

Twp. 22

Rge.

2 OW

Company

Vickers Pet.

FarmName

College

No.

1

TOPS	DEPTH	LOG	DATUM	Loc. in Sec.
Anh.	1295			SE SE NW
Tp. 77 Pile	2200		42	
H. 1	3723	3723	1565	
Tr. 11	3740		1582	
Dg.	3756		1598	
BL.				
L.	3796	3792	1634	Geol.
K.C.				
B.K.C.				Contr.
Ce.				Harms-Burt
C.				
M.	4359	4354	2196	Pool
M.				
K. sh		4415	2257	Wildcat
ME Kk sd.	4428	4423	2265	
Mo.				
V. dolo	4473	4464	2306	
S. sh	4673		2515	
S. sd	4686	4680	2522	
A	4739	4734	2576	
R.				
Pe.				
G.				
TD.	4771	4768		

ABANDONED

Date Comm. 10-27-55

NOV 16 1955

8" @ 587/400 DST 4362-70' open 1 1/2 hr.

rec. 30' mud 550# DST 4362-85

open 1 hr. rec. 35' mud 1135/60"

D & A