


FORM 51 IOM 12-46 PETROL KANSAS Stafford

Section 30 Township 22 Range 12W

Well No. 1 Witt

Company Threeway Drlg., et al

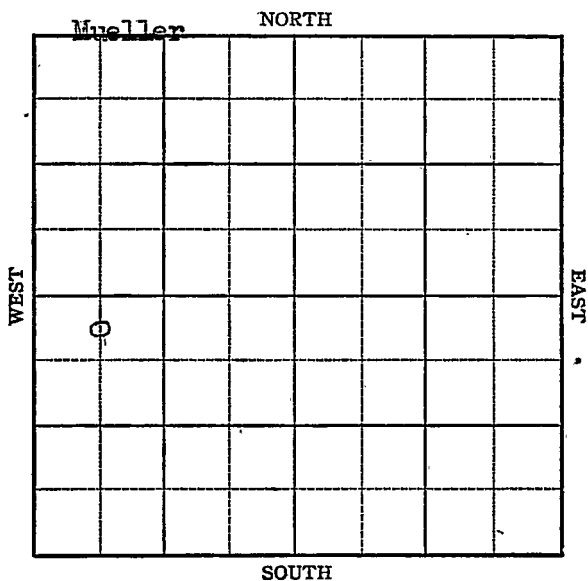

KANSAS Stafford ✓

Sec. 30 Twp. 22 R. 12W

Well No. #1 Witt Farm

Threeway Drlg. et al Company
Mueller


330 Ft. from N. Line

 Ft. from S. Line

 Ft. from E. Line

660 Ft. from W. Line

C N L NW SW

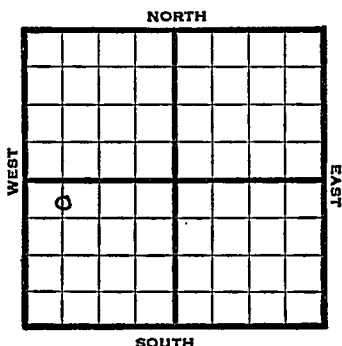

1947

Elev. 1871

REPORT

4/2 Drlg. 150'.

4/9 10" @ 240'
Anhydrite 695
Drlg. 2605'

4/15 Topoka 2905'
Drlg. 3100'

4/23 Lans 3362'
Arb. 3785
TD 3785'

ABANDONED

Map No. K46 Sec. 30 Twp. 22 R. 12W

Well No. 1 Witt


Threeway Drlg. etal. Company

FIRST REPORT

Contractor

C N L NW SW

SECTION PLAT

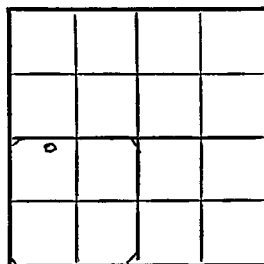

330 Ft. from N. Line

 Ft. from S. Line

 Ft. from E. Line

660 Ft. from W. Line

Stafford County

Location

Rig up

Drilling and Remarks:

drlg. 150

RECORD

Cased in. ft.

Sand

Gas

Oil

Total Depth

PRODUCTION

1st 24 hrs. Nat.

1st 24 hrs. after shot

Gas Cu. Ft.

Dry Hole

Abandoned

Date

APR 2 1947 19 S. J. LEWIS Scout

Map No. 46 Sec. 30 Twp. 22 R. 12W

Well No. 1 Witt

Threeway Drlg. etal. Company

ABANDONED

Contractor

C N L NW SW


E 1/8 1/4
SECTION PLAT

330 Ft. from N. Line

 Ft. from S. Line

 Ft. from E. Line

660 Ft. from W. Line

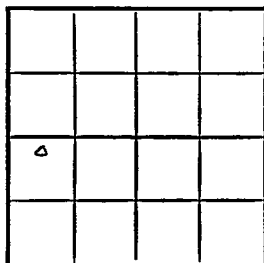

Stafford County

Location

Rig up

Drilling and Remarks:

Lone 2362

Cor 8770

RECORD

Cased in., ft.

Sand

Gas

Oil

Total Depth 2785

PRODUCTION

1st 24 hrs. Nat.

1st 24 hrs. after shot

Gas Cu. Ft.

Dry Hole

Abandoned

Date

APR 22 1947 19

S. J. LEWIS Scout