


Section 30 Township 22 Range 13 WWell No. # 1 MoonCompany Rocket Drlg.

NORTH

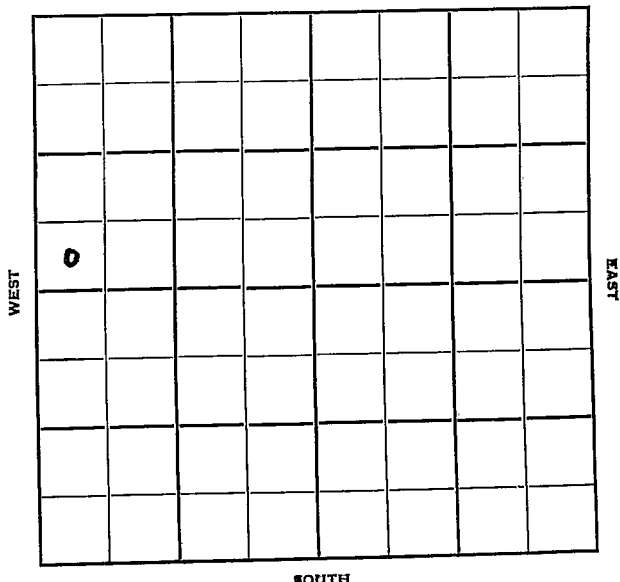

Stafford

KANSAS

Sec. 30 Twp. 22 R. 13W

Well No. #1 Moon Farm

Rocket Drlg. Company

Contractor


Ft. from N. Line

330 Ft. from S. Line

Ft. from E. Line

330 Ft. from W. Line

SW SW NW

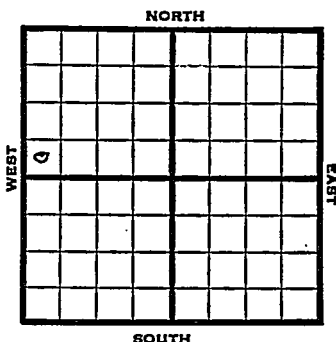

1952

Elev. 1923' REPORT

10/8

Spud 10-6-52
8" @ 326' WOC

10/15

Drlg. 3715'

10/22

Spud 10-6-52
D & A TD 3940' 8" @ 326
Heeb 3333' Br. lime 3464'
Lans. 3479' Viola 3785'
DST 3788-3847 open 1 hr. rec 15' mud
Simp. sh. 3842' Simp sd. 3867'
Arb. 3899'
TD 3940' D & A

ABANDONED

County **Stafford** State **Kansas**Sec. **30** (Blk. Twp.) **22** (Sur. Rge.) **13W** Map No.Operator **Rocket Drlg.**Well No. **1** Farm **Moon**Elev. Location **SW SW NW**

0							

330 Ft. From **S** Line **NW****330** Ft. From **W** Line **Quarter**1st. Report **OCT 8 1952**

Completion

Remarks **Sinclair - DHM**Spudding Date **10-6-52**

Drlg. Data

8" @ 326 WOC

J. G. McGEHEE

County Stafford State Kansas
 Sec. 30 (Blk.) 22 (Sur.) 13W Map No.
 Operator Rocket Drlg.
 Well No. 1 Farm Moon
 Elev. 1923 Location SW SW NW

0							

330 Ft. From S Line NW

330 Ft. From W Line Quarter

1st. Report

Completion OCT 22 1952

Remarks

Spudding Date 10-6-52

Drlg. Data D & A TD 3940

8" @ 326 Heeb. 3333 Br. lime 3464

Lans. 3479 Viola 3785 DST 3788-3847

open 1 hr. Rec. 15' mud Simp. sh. 3842

Simp. sd. 3867 Arb. 3899 TD 3940

D & A