


Section 30 Township 22 Range 13-WWell No. #1 Norris EstCompany Finston & Murfin

NORTH

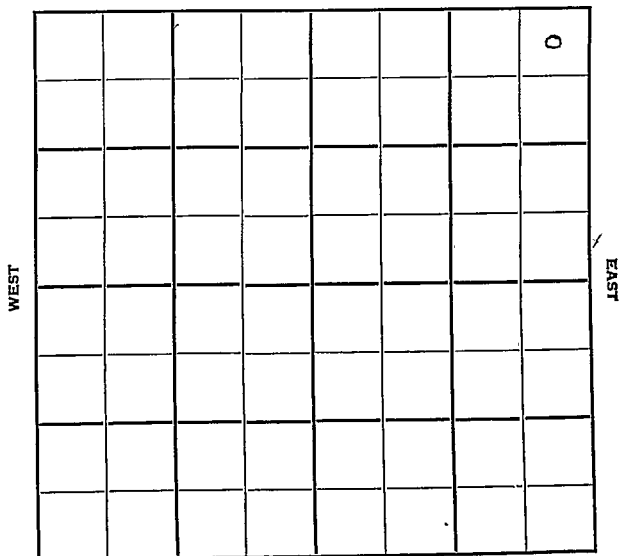

SOUTH

Stafford **KANSAS** 22 R. 13W

Sec. 30 Twp. 22 R. 13W

Well No. #1 Norris Est. Farm

Finston & Murfin Company

Contractor

Wildcat


330' Ft. from N. Line

 Ft. from S. Line

330' Ft. from E. Line

 Ft. from W. Line

NE NE NE

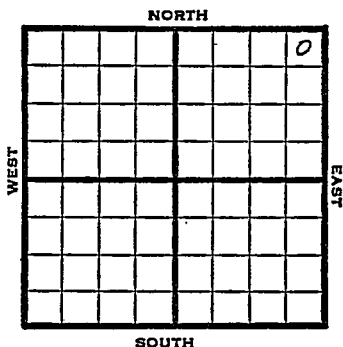

1950 Elev 1905 REPORT

6/28 Spud 6-26-50
8" @ 349'

7/12 8" @ 349
Neeb 3318 Toronto 3347
Br lime 3460 Lans 3478
DST 3661-69 opn 50 min, rec 70' ocm
Cong 3802 Viola 3809
Simp 3861 Arb 3900
TD 3950
D&A

ABANDONED

Map No. _____ Sec. 30 Twp. 22 R. 13W

Well No. 1 Norris Est.

Finston & Murfin Company

Contractor

NE NE NE


330 Ft. from N. Line

Ft. from S. Line

330 Ft. from E. Line

Ft. from W. Line

SECTION PLAT

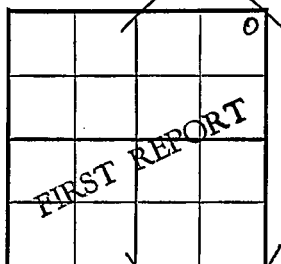

Stafford County

Zephyr & Sinclair DHM

Location _____

Rig up _____

Drilling and Remarks:

Spud 6-26-50

8" @ 349

RECORD

Cased _____ in., _____ ft.

Sand _____

Gas _____

Oil _____

Total Depth _____

PRODUCTION

1st 24 hrs. Nat. _____

1st 24 hrs. after shot _____

Gas _____ Cu. Ft.

Dry Hole _____

Abandoned _____

Date

JUN 28 1950 19

J. E. TYRA Scout

Map No. _____ Sec. 30 Twp. 22 R. 13W

Well No. 1 Norris Est.

Finston & Murfin Company

Contractor

NE NE NE


El. 1905
SECTION PLAT

330 Ft. from N. Line

Ft. from S. Line

330 Ft. from E. Line

Ft. from W. Line

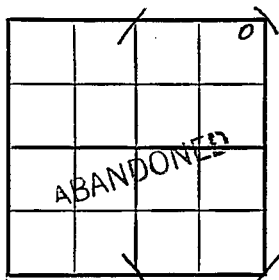

Stafford County

Location _____

Rig up _____

Drilling and Remarks:

8" @ 349

Heeb. 3318

Toronto 3347

Br. line 3460

Lans. 3478

DST 3661-69

open 50 min.

RECORD

Cased _____ in., _____ ft.

Sand _____

Gas _____

Oil _____

Total Depth 3950

PRODUCTION

1st 24 hrs. Nat. _____

1st 24 hrs. after shot _____

Gas _____ Cu. Ft.

Dry Hole _____

Abandoned _____

Date

JUL 12 1950 19 J. E. TYRA Scout


to A I 2 3 4

--- T ---

--- 2 ---



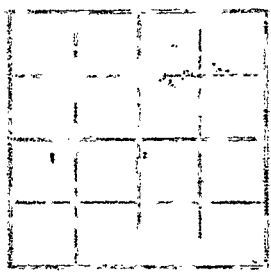










JUL 21

NO TO POST	
Scout Cards	50
Land Small Map	
Land Wall Map	3
Tracings	
France Map	
Pierce Map	
Misc.	

0561

D & A

TD 3950

Arb. 3900

Stamps 3861

Viola 3809

Comp. 3802

Rec. 701 ocm