



Sec. 30 Twp. 22 R. 9W


Well No. #1 Leslie Farm

Pickrell Drlg. Company

Peace Creek Pool

NORTH

           Ft. from N. Line

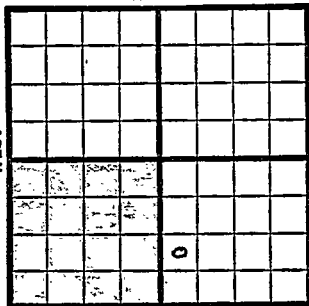

990' Ft. from S. Line

           Ft. from E. Line,

330' Ft. from W. Line

NW SW SE

SOUTH

1949 Elev 1728' REPORT

4/27 8" @ 260'

5/4 Lansing 3196'  
Viola 3677'  
TD 3681'  
5" @ 3681'

5/10 TD 3706'  
Swb 1 bbl oil & 2 W PH  
400' off bottom

5/17 Swb & 5 bbls oil & 12 WPH

5/25 "

6/1 "

6/8 Viola 3677'  
5" @ 3681'  
TD 3706'  
Pump 25 Oil / 75 W Pot  
42° Gr.  
Comp

**COMPLETED**

Map No. \_\_\_\_\_ Sec. 32 Twp. 22 R. 9W

Well No. 1 Leslie

Pickrell Drlg. Company

**FIRST REPORT**

Contractor

NW SW SE

**SECTION PLAT**

\_\_\_\_\_ Ft. from N. Line

990 Ft. from S. Line

\_\_\_\_\_ Ft. from E. Line

330 Ft. from W. Line

		6	

Reno County

Location \_\_\_\_\_

Rig up \_\_\_\_\_

Drilling and Remarks:

8" @ 260

**RECORD**

Cased \_\_\_\_\_ in., \_\_\_\_\_ ft.

Sand \_\_\_\_\_

Gas \_\_\_\_\_

Oil \_\_\_\_\_

Total Depth \_\_\_\_\_

**PRODUCTION**

1st 24 hrs. Nat. \_\_\_\_\_

1st 24 hrs. after shot \_\_\_\_\_

Gas \_\_\_\_\_ Cu. Ft.

Dry Hole \_\_\_\_\_

Abandoned \_\_\_\_\_

Date

APR 27 1949

19

S. J. LEWIS

Scout



