

FORM M41

DRILLING WELL COMPLETION REPORT

Well No. One (1) Farm Name J. C. Smisor
 Date completed June 24, 1942
 Description SW $\frac{1}{4}$ Sec. 30-22S-9W
 County Reno, State Kansas
 Initial production 7040 bbls. Total depth 3706 feet
 Initial volume _____ cu. ft. _____ lbs. rock pressure
 Pipe Line Company Stanolind Pipe Line Co.
 Gas Company _____
 Remarks: Potential taken by bomb test method. Maximum allowed potential 3000
Bbls. Estimated Daily allowable 29 Bbls.

Commodity
6W

Accounting Dept. ✓
 Rental Dept.
 Scouting Dept.
 Engineering Dept.
 Legal Dept.
 Lease Inventory Man
 Tax Dept.
 Geological
 File

*I think correct - one well
 of a 40 should have a better
 allowable J.F.*

Scout Dept

LOG
MID-CONTINENT PETROLEUM CORPORATION
J. C. Smisor Well #1 Sec. 30 Twp. 22
R. 9W Reno County, Kansas

Cellar	0	10
Sand	10	40
Shells	40	124
Red bed	124	280 Set, 266'8" of 10-3/4" OD
Shale & Shells	280	390 casing at 275' 8" from
Shale & Shells	390	890 rig floor, Top coupling
Shale	890	1275 8'4" below rig floor
Lime & shale	1275	1305 cemented by Halliburton
Shells & shale	1305	1455 with 200 sacks
Shale & lime	1455	1575
Lime	1575	1700
Lime & shale	1700	1805
Lime	1805	1970
Lime & shale	1970	2215
Shale	2215	2365
Lime & shale	2365	2475
Lime	2475	2530
Lime & shale	2530	2690
Lime	2690	3025
Shale	3025	3100
Shale & lime	3100	3215
Lime	3215	3270
Lime	3270	3320 Kansas city
Lime	3320	3345 Cherty
Lime	3345	3485
Shale	3485	3490
Lime	3490	3538
Lime	3538	3547 Cherty
Lime	3547	3550
Shale & shells	3550	3607
Shale	3607	3675
Shale	3675	3676
Lime Viola	3676	3691 Top 3676 from Rig floor.
Dolomite	3691	3692 Show of gas & oil
Viola lime hard	3692	3701
Chert & Dolomite	3701	3706 Total depth, show of gas & oil

Total Depth 3706


RECORD OF CASING					
SIZE	WEIGHT	KIND	RUN IN	PULLED OUT	LEFT IN
10 OD	35 lbs	S.H. Lapweld	266'8"	None	266'8"
7" OD	24	S.H. Seamless	2315'4"	None	2315'4"
7" OD	20	New Seamless	1368'2"	None	1368'2"
Total 7" OD Casing set			3683'6"	None	3683'6"

cc: Geological Dept.
Scouting Dept.

LOCATION NOTICE

TULSA, OKLA., April 20, 19 42WELL NO. One (1) ON J. C. Smisor FARM

WILL BE AS FOLLOWS:

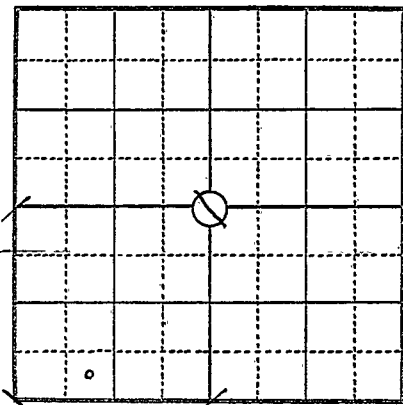

..... FEET FROM NORTH LINE

..... FEET FROM EAST LINE

..... 330 FEET FROM SOUTH LINE..... 990 FEET FROM WEST LINELots 3 and 4, and $\frac{1}{2}$ SW $\frac{1}{2}$ (SW $\frac{1}{2}$)IN SEC. 30 TWP. 22S RANGE 9W..... Now COUNTY, STATE OF KansasREMARKS: Lloyd Snyder, Supt.S. K. McInishan, ForemanSIGNED *[Signature]*

COPIES TO


DISTRICT SUPT.
 ACCOUNTING DEPT.
 RENTAL DEPT.
 SCOUTING DEPT. ✓
 ENGINEERING DEPT.
 LEGAL DEPT.
 LEASE INVENTORY
 CLAIM DEPT.
 TAX DEPT.
 GEOLOGICAL DEPT.
 FILE
 PURCHASING DEPT.

Handwritten:
 Cards RA?
 county map
 road map

CORRECTED LOCATION NOTICE

TULSA, OKLA., April 20, 19 42WELL NO. One (1) ON J. C. Snisor FARM

WILL BE AS FOLLOWS:

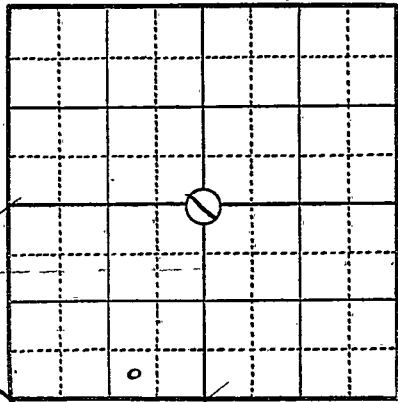

..... FEET FROM NORTH LINE

..... 330 FEET FROM EAST LINE

..... 330 FEET FROM SOUTH LINE

..... FEET FROM WEST LINE


Rebo COUNTY, STATE OF Kansas

REMARKS: Lloyd Snyder, Supt.S. K. McLanahan, ForemanSIGNED W. Moody

COPIES TO

DISTRICT SUPT.

ACCOUNTING DEPT.

RENTAL DEPT.

SCOUTING DEPT. ✓

ENGINEERING DEPT.

LEGAL DEPT.

LEASE INVENTORY

CLAIM DEPT.

TAX DEPT.

GEOLOGICAL DEPT.

FILE

PURCHASING DEPT.