

FORM M41

DRILLING WELL COMPLETION REPORT

Well No. Two (2) Farm Name J. C. SmisorDate completed July 23, 1942Description SW $\frac{1}{2}$ Sec 30-22 S-9WCounty Reno, State KansasInitial production 239 bbls. Total depth 3699 feet

Initial volume _____ cu. ft. _____ lbs. rock pressure

Pipe Line Company Stanolind

Gas Company _____

Remarks: Minimum Allowable-15 Bbls.


Accounting Dept.
 Rental Dept.
 Scouting Dept. ✓
 Engineering Dept.
 Legal Dept.
 Lease Inventory Man
 Tax Dept.
 Geological
 File

Accounting Dept.

MID-CONTINENT PETROLEUM CORPORATION
WELL RECORD

Kansas

J. C. Smisor Well No. 2 - SW $\frac{1}{4}$ Sec. 30-22S-9W, Reno County, Kansas
330' from South and 330' from West Lines
Drilling commenced June 29, 1942; completed July 14, 1942.
Contractor: Barnett Drilling Company
Production Potential test on pump, 239 bbls.

Sand	0	70	
Sand & Shale	70	150	
Shale & Shells	150	287	- Set 281'7" of 8-5/8" at 287'; top coupling 7'6" below
Surface clay	287	540	rig floor; cemented w/200 sacks by Halliburton
Shale & Shells	540	556	
Anhydrite	556	592	
Shale & Shells	592	1100	
Sand & Shells	1100	1200	
Shale & Shells	1200	1315	
Gyp	1315	1350	
Shale & Shells	1350	1410	
Lime	1410	1460	
Shale & Shells	1460	1700	
Chert & Lime	1700	1725	
Lime & Shale	1725	1815	
Shale & Shells	1815	1985	
Lime & Shale	1985	2125	
Shale & Shells	2125	2610	
Lime & Shale	2640	2715	
Lime	2715	3005	
Shale & Shells	3005	3235	
Lime & Shells	3235	3290	
Kansas City Lime	3290	3350	
Lime	3350	3449	
Lime & Chert	3449	3525	
Lime	3525	3595	
Shale	3595	3645	
Shale & Lime	3645	3670	- Top Viola Lime 3670'
Viola	3670	3672	
Red Viola Lime	3672	3682	- Broken
Viola Lime, White	3682	3685	- Firm w/green streaks
Lime	3685	3695	- Porosity 3688-3692
Cherty lime	3695	3699	- Good porosity & oil stain in recovery
		3699	- Total Depth

Cored with rotary tools

First core	3672	3685	- 10' recovery
Second "	3685	3699	- 10' recovery

CASING RECORD

<u>Size & Kind</u>	<u>Amount Set</u>	<u>Cement used</u>
8-5/8" 24# SH Lapweld	281' 7"	200 sacks
5-1/2" 17# SH S. S.	3676'	122 sacks

SAND RECORD

Viola Lime 3670 to 3699'


*Cards
Paul*

LOCATION NOTICE

TULSA, OKLA., June 20, 1942

WELL NO. Two (2) ON J. E. Swison FARM

WILL BE AS FOLLOWS:

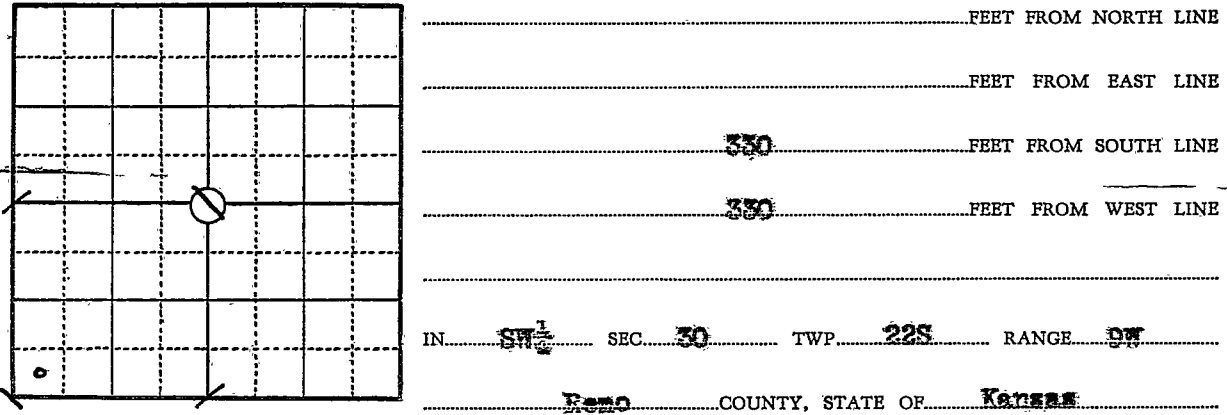

REMARKS: Lloyd Snyder, Dist. Supt.

S. K. McLaughan, Dist. Foreman

SIGNED *[Signature]*

COPIES TO

- DISTRICT SUPT.
- ACCOUNTING DEPT.
- RENTAL DEPT.
- SCOUTING DEPT. ✓
- ENGINEERING DEPT.
- LEGAL DEPT.
- LEASE INVENTORY
- CLAIM DEPT.
- TAX DEPT.
- GEOLOGICAL DEPT.
- FILE
- PURCHASING DEPT.

road map
swamp map
[Signature]