

KANSAS

Reno


FORM 51 5M 4-41 PETROL

Section 30 Township 22 Range 9-W

Well No. #2 Smisor

Company Mid-Continent Petr. Corp.

NORTH Peace Creek Pool

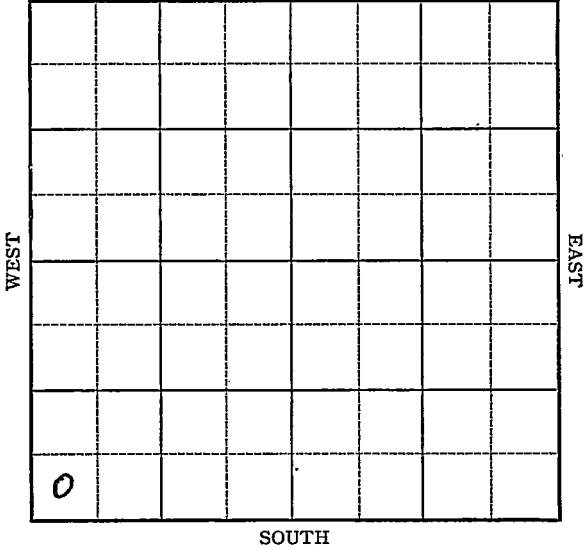

Sec. 30 Twp. 22-S R. 9-W

Well No. #2 J. C. Smisor Farm

Mid-Continent Petr. Corp. Company

(Peace Creek Pool)


_____ Ft. from N. Line

330 Ft. from S. Line

_____ Ft. from E. Line

330 Ft. from W. Line

Elev. 1735

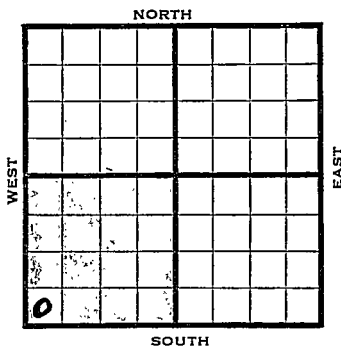

1942

REPORT

6/20

Location (Location notice)

6/24

Material.

*12' H #1
4' H 14 #1*

6/26

Expect to have derrick complete to-night. (Letter)

6/27

Derrick completed. (Letter)

7/1

8" - 274' WOC.

7/3

Drlg. 1295' (Letter)

7/8

Drlg. 2910'

7/9

Drilling 3055'

7/11

T. D. 3525 repairing bent drive shaft

7/14

Top Viola 3670 (by cuttings)
Cored 3672-85 Rec. 10 feet No show
Cored 3685-99 Recovered 10 feet
Lost the bottom 4 feet which they think is the pay From 3694-95 showed oil
Will run 5" casing around 3682 (Tel)

7/15

5" - 3682' RUST.

Running 12' higher on Viola than our #1 Smisor east offset
Running 41' higher on Viola than Hinkle #1 Schweizer SE NW 31-22-9W completed for 774 oil & 32 wtr. on pump (Peabody)

OVER

7/19 Top Viola 3670 5" 3681 TD 3699
Drilled plugs Cleaned out and bailed
10 gallons oil per hour No water
Will acidize with 500 gallons thru casing
to see if lime will take acid Will then
give more acid or may shoot (Tel)

7/21 Acidized 500 gallons thru casing
Swabbed off the load
1st hour swab 7 bbls.
2nd " " 9 "
3rd " " $9\frac{5}{4}$ "
4th " " $9\frac{1}{2}$ "
Made 3 bbls. salt water
Ran bailer to bottom 5 times
Recovered 1/2 bailer salt water each time
Will run tubing and rods. and take potential

7/23 Pumping potential 239 bbls. (Tel)

7/23 Hourly gauges on potential:
1st hour 13.50 bbls.
2nd " 9.10 "
3rd " 9.80 "
4th " 9.45 "
5th " 9.45 "
6th " 9.80 "
7th " 8.75 "
8th " 9.80 "
Total 79.65 "
Potential 239 bbls. Very little water
(Letter)

7/29 Viola 3670'
5" - 3681'
500 acid
T.D. 3699'
Pump. 239 Pot.
Gravity 42.

COMPLETED

Reno KANSAS

Map No. 49 Sec. 30 Twp. 22 R. 9WWell No. 2 Smisor

Mid-Continent Petr. Corp. Company

~~FIRST REPORT~~ Contractor

SW/ C

SECTION PLAT

_____ Ft. from N. Line

330 Ft. from S. Line

_____ Ft. from E. Line

330 Ft. from W. Line

PEACE CREEK POOL

RECORD

Location _____

Cased _____ in., _____ ft.

Rig up _____

Sand _____

Drilling and Remarks:

Gas _____

Oil _____

Material _____

Total Depth _____

PRODUCTION

1st 24 hrs. Nat. _____

1st 24 hrs. after shot _____

Gas _____ Cu. Ft.

Dry Hole: _____

Abandoned _____

Date

JUN 24 1942 19S. J. LEWIS Scout

Map No. 49 Sec. 30 Twp. 22 R. 9W

Well No. 2 Smisor

Mid-Continent Petr. Corp. Company

COMPLETED Contractor

SW/C

SECTION PLAT

_____ Ft. from N. Line

330 Ft. from S. Line

_____ Ft. from E. Line

330 Ft. from W. Line

PEACE CREEK POOL

Location _____

Rig up _____

Drilling and Remarks:

*Vista 3670
5" @ 3687
500 acid
Pump 239 P.J.
42 2/3*

RECORD

Cased _____ in., _____ ft.

Sand _____

Gas _____

Oil _____

Total Depth 3689

PRODUCTION

1st 24 hrs. Nat. _____

1st 24 hrs. after shot _____

Gas _____ Cu. Ft.

Dry Hole _____

Abandoned _____

Date

JUL 29 1942 19

S. J. LEWIS Scout