


Section 30 Township 22 Range 9-W

Well No. #5 Smisor

Company Mid-Continent Petroleum
Peace Creek Pool

NORTH

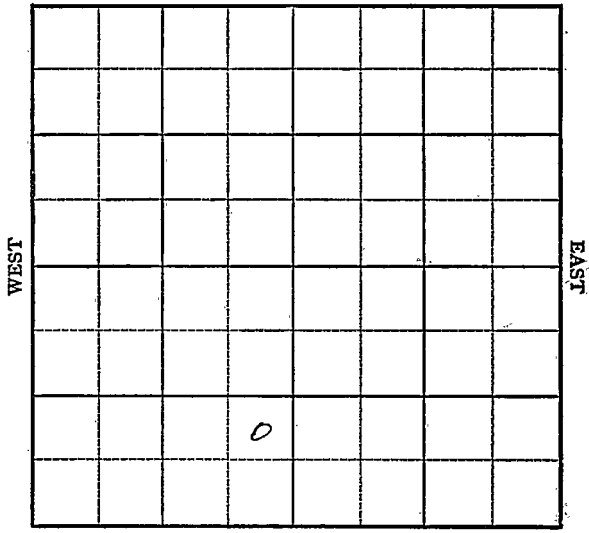

SOUTH


HOT FILE

KANSAS

Reno Co.

Sec. 30 Twp. 22S R. 9W ✓Well No. #5 J.C. Smisor FarmMid Continent Pet CompanyBarnett Drlg. Co. Contractor Ft. from N. Line990 Ft. from S. Line330 Ft. from E. Line Ft. from W. Line

NE SE SW

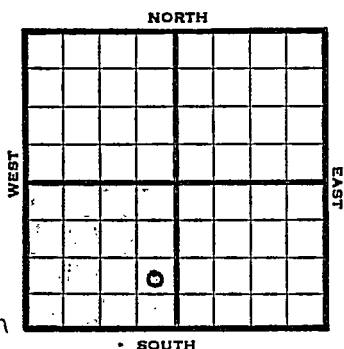

1949	Elev. 1729'	REPORT
		3700' Test
11/21		Location notice
11/23		Spudded 11-21-49
		Set 10-3/4" casing. (D R)
11/25		Drilling 1500' "
11/28		Drilling 2285'. "
11/29		Drilling 2545'. "
11/30		Drilling 2730'. "
12/1		No report. "
12/2		Drilling 3010'. "
12/5		Drilling 3365'. "
12/6		Drilling 3455'. "
12/7		Drilling 3580'. "
12/8		Drilling 3680' "
		Top Viola 3676'. "
12/9		No report. "
12/12		Set 7" at 3679' with 200 sacks. "
		TD. 3680'.
12/13		WOC. "
12/14		Drilling 3696' hard lime, no show. "
12/15		Pay 3702'-06'
		Acidized with 500 gal.
		Swabbing & testing, showing oil and gas. "
12/16		Testing. "
12/19		Testing. "
12/20		Testing. "
12/21		Testing. "
12/22		Will put on pump & test. "

VER

1949

12/23	Preparing to set pump ^{ing} unit.	(D R)
12/27	Preparing to set pumping unit.	"
12/28	Preparing to set pumping unit.	"
12/28	Viola 3675'	
	7" @ 3679'	
	Acid 2000	
	Pump 15 oil Pot.	
	Gr. 42 ⁰	
	TD 3717'	

COMPLETED

Map No. _____ Sec. 30 Twp. 22 R. 9W

Well No. 5 Smisor

Mid-Continent Petroleum Company

Contractor _____

NE SE SW

**FIRST REPORT
SECTION PLAT**

_____ Ft. from N. Line

990 Ft. from S. Line

330 Ft. from E. Line

_____ Ft. from W. Line

Reno County

Location _____

Rig up _____

Drilling and Remarks: _____

10" @ 273

w/ 200 sax

RECORD

Cased _____ in., _____ ft.

Sand _____

Gas _____

Oil _____

Total Depth _____

PRODUCTION

1st 24 hrs. Nat. _____

1st 24 hrs. after shot _____

Gas _____ Cu. Ft.

Dry Hole _____

Abandoned _____

Date

NOV 23 19 19

S. J. LEWIS Scout

Kansas

Peace Creek Pool

Map No. _____ Sec. 30 Twp. 22 R. 9WWell No. 5 SmisorMid-Continent Petroleum Company

COMPLETE

Contractor

NE SE SW

E11729
SECTION PLAT

	0		

_____ Ft. from N. Line

990 Ft. from S. Line330 Ft. from E. Line

_____ Ft. from W. Line

Reno County

Location _____

Rig up _____

Drilling and Remarks:

Vista 36757" @ 36792000 acidProd 15 oil BT420 lb

RECORD

Cased _____ in., _____ ft.

Sand _____

Gas _____

Oil _____

Total Depth 2712

PRODUCTION

1st 24 hrs. Nat. _____

1st 24 hrs. after shot _____

Gas _____ Cu. Ft.

Dry Hole _____

Abandoned _____

Date

DEC 28 1949 19S. J. LEWIS

Scout