

Map No.

KANSAS

Sec.

30

Twp.

22

R.

11W

Well No.


1-Komynck
Stanolink Oil Co.

Farm

Company

NORTH

WEST

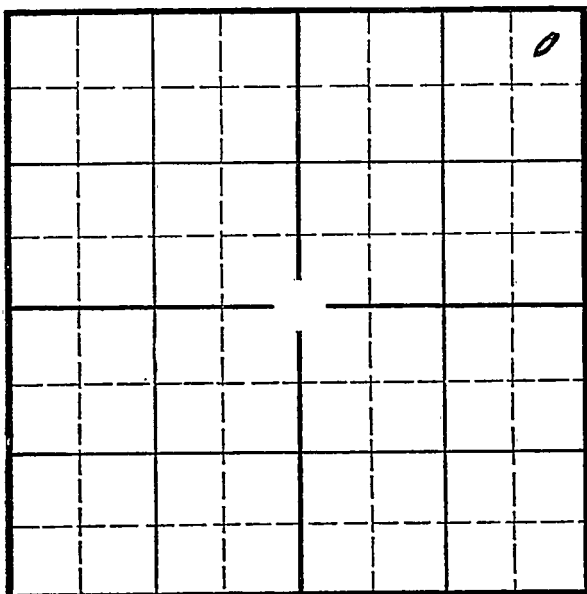

EAST

SOUTH

Location

Drilling Remarks

Rig Up

Drilling Remarks

RECORD

Cased _____ in. _____ ft.

Sand _____

Gas _____

Oil _____

Total Depth _____

PRODUCTION

1st 24 hrs. Nat. _____

1st 24 hrs. after shot _____

Gas _____ cu. ft. _____

Dry Hole _____

Abandoned _____

Map No. KANE Sec. 30 Twp. 22 R. 11
Well No. 1- Kormazek Farm
Stanolink O & H. Company


330 Ft. from N. Line

Ft. from S. Line

330 Ft. from E. Line

Ft. from W. Line

Elev. 4835

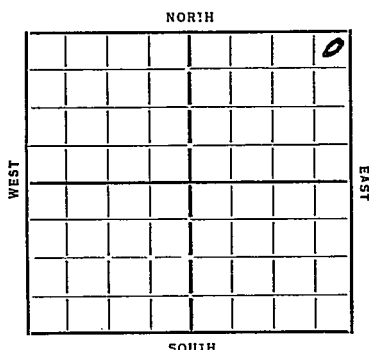

Date _____

REPORT

Bldg Rig
Bldg 3425
K.C. 3293 7" 3570
Sil 3575 H. 7.
Sil 3570
TD 3584
927 Bldg

COMPLETED

Shofford
 Map No. *46* Sec. *30* Twp. *22* R. *11W*

Well No. *1-Komarek*

Stanford O & G. Company

Contractor

FIRST REPORTS

330 Ft. from N. Line

Ft. from S. Line

330 Ft. from E. Line

Ft. from W. Line

SECTION PLAT

			<i>0</i>

Location

Rig up

Drilling and Remarks:

Red Rig

RECORD

Cased _____ in., _____ ft.

Sand _____

Gas _____

Oil _____

Total Depth _____

PRODUCTION

1st 24 hrs. Nat. _____

1st 24 hrs. after shot _____

_____ Cu. Ft.

Dry Hole _____

Abandoned _____

Date

9-4-35 192

Scout

KANSAS

Map No. 46 Sec. 30 Twp. 22 R. 11 WWell No. 1- KamarekStanolind Oil & Gas Company

Contractor

SECTION PLAT

			0

330 Ft. from N. Line

..... Ft. from S. Line

330 Ft. from E. Line

..... Ft. from W. Line

Location.....

Rig up.....

Drilling and Remarks:

927 bbls

RECORD

Cased..... in. ft.

Sand oil 3570

Gas.....

Oil.....

Total Depth 3584

PRODUCTION

1st 24 hrs. Nat.....

1st 24 hrs. after shot.....

Gas..... Cu. Ft.

Dry Hole.....

Abandoned.....

Date

ORVAL MANNSCHRECK

10-30-35 192

Scout