


STAFFORD

Form 51-5M-3-35-Mid-West

Map No. KANSAS Sec. 30 Twp. 22 R. 11-W

Well No. 3-Komerak Farm
Stanolind O & G Company

NORTH

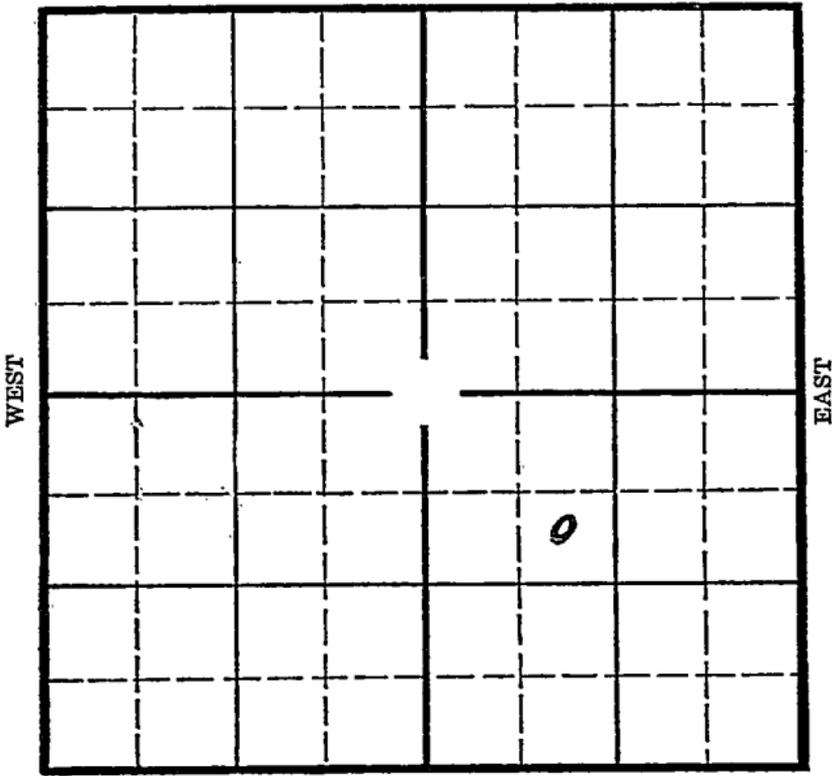

SOUTH

Location _____
Drilling Remarks _____

Rig Up _____
Drilling Remarks _____

RECORD

PRODUCTION

Cased _____ in. _____ ft.
Sand _____
Gas _____
Oil _____
Total Depth _____

1st 24 hrs. Nat. _____
1st 24 hrs. after shot _____
Gas _____ cu. ft. _____
Dry Hole _____
Abandoned _____

Stafford
22 R. 11^W

Map No. _____ Sec. 30 Twp. _____ R. _____

Well No. 3-Komergh Farm _____

Standard Oil Co Company _____


990 Ft. from N. Line

_____ Ft. from S. Line

_____ Ft. from E. Line

990 Ft. from W. Line

Elev. 1820

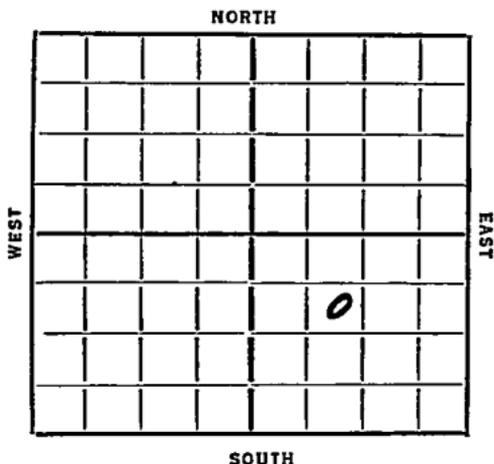

REPORT

1936	
3/11	Location
3/13	--
3/20	Rign up rotary.
3/27	--
4/2	T. Anhy 520' Drlg. 13"-215' Drlg. 1330'
4/10	Drlg. 2740'
4/16	8" @ 2735' T.D. 2738'. Rust.
4/23	--
4/30	Drlg. 2922'.
5/7	Drlg. 3106'.
5/14	Run 7" @ 3200'.
5/21	Lansing 3285'.
5/28	6" @ 3328'. S.O. 3378-83'. Water 3380-87'. Drlg. 3389'.
6/4	S.O. 3459-65'. T.D. -
6/11	Sil. 3540'. T.D. 3541'. U.R. 6".
6/24	36-Sil. 3540'. T.D. 3569'. 786 bbls of oil natural.

COMPLETED

Map No. 49 Sec. 30 Twp. 22 R. 11W

Well No. 3-Komerak

Stanolind O + G. Company

Contractor

FIRST REPORTS

SECTION PLAT

990 Ft. from N. Line
 _____ Ft. from S. Line
 _____ Ft. from E. Line
990 Ft. from W. Line

		0	

Location _____
 Rig up _____
 Drilling and Remarks:

RECORD

Cased _____ in., _____ ft.
 Sand _____
 Gas _____
 Oil _____
 Total Depth _____

PRODUCTION

1st 24 hrs. Nat. _____
 1st 24 hrs. after shot _____
 Gas _____ Cu. Ft.
 Dry Hole _____
 Abandoned _____

Date

3-11-36 192

ORVAL MANNSCHRECK

Scout

KANSAS

Map No. 46 Sec. 30 Twp. 22 R. 11W

Well No. 3 Komorak

Standard Company

Contractor

SECTION PLAT

990 Ft. from N. Line

_____ Ft. from S. Line

_____ Ft. from E. Line

990 Ft. from W. Line

COMPLETED

Location _____

Rig up _____

Drilling and Remarks:

Sil 3540

786 8 1/2 / Nat

RECORD

Cased _____ in., _____ ft.

Sand _____

Gas _____

Oil _____

Total Depth 2569

PRODUCTION

1st 24 hrs. Nat. _____

1st 24 hrs. after shot _____

Gas _____ Cu. Ft.

Dry Hole _____

Abandoned _____

Date

JUN 24 1936₁₉

S. J. LEWIS

Scout