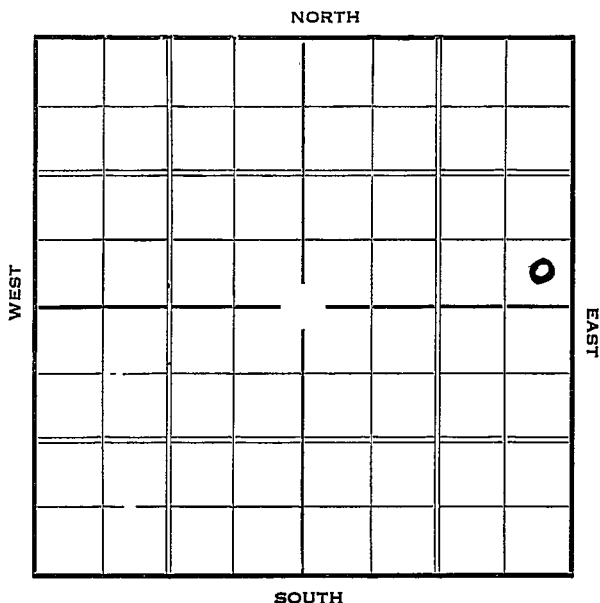


Section 30 Township 22 Range 11-WWell Number 6- KomarekCompany Stanolind

Stafford **KANSAS**
 Map No. _____ Sec. 30 Twp. 22 R. 11 ^W

Well No. 6-Kornarek
Stanolind Company

Contractor _____

FIRST REPORT

SECTION PLAT

			0

_____ Ft. from N. Line
330 Ft. from S. Line
330 Ft. from E. Line
 _____ Ft. from W. Line

Location ✓

Rig up _____

Drilling and Remarks:

RECORD

Cased _____ in., _____ ft.

Sand _____

Gas _____

Oil _____

Total Depth _____

PRODUCTION

1st 24 hrs. Nat. _____

1st 24 hrs. after shot _____

Gas _____ Cu. Ft.

Dry Hole _____

Abandoned _____

Date

APR 28 1937

19

H. D. Hatfield Scout

Map No. 46 Sec. 30 Twp. 22 R. 11 WWell No. 6 - KomarekStanolind Company

Contractor

COMPLETED

SECTION PLAT

			0

_____ Ft. from N. Line

330 Ft. from S. Line330 Ft. from E. Line

_____ Ft. from W. Line

Location _____

Rig up _____

Drilling and Remarks:

2000 AcidPat - 1709

RECORD

Cased 6 in., 3548 ft.Sand 511 3548

Gas _____

Oil _____

Total Depth 3570

PRODUCTION

1st 24 hrs. Nat. _____

1st 24 hrs. after shot _____

Gas _____ Cu. Ft.

Dry Hole _____

Abandoned _____

Date

JUL 21 1937

19

H. D. Hatfield

Scout