


Stafford


KANSAS

Section 30 Township 22 Range 11-W

Well Number 7 - Komarek

Company Stanolind

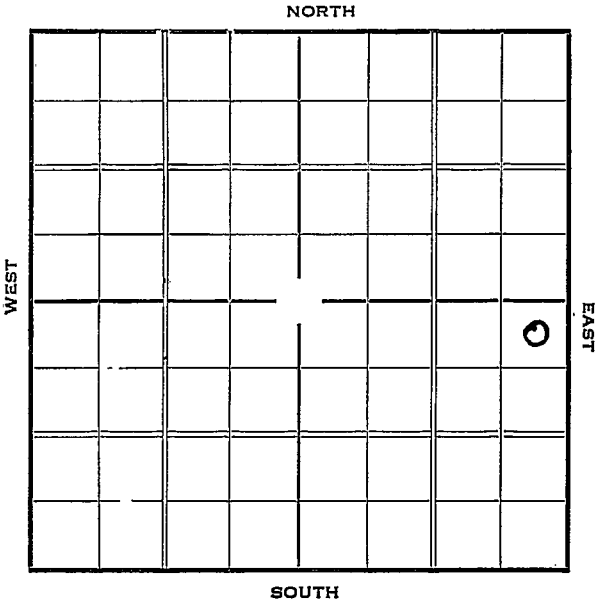

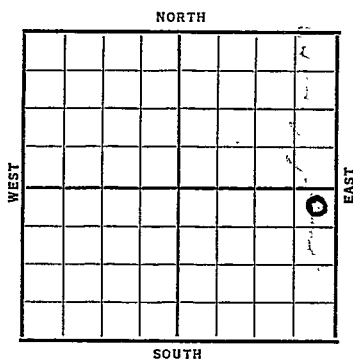Sec. 30 Twp. 22 R. 11-WWell No. 7 - Komarek FarmStanolind Company330 Ft. from N. Line Ft. from S. Line330 Ft. from E. Line Ft. from W. Line

Date	REPORT
1937	
4/28	Location
5/7	"
5/14	"
5/21	"
5/28	"
6/4	"
6/11	"
6/19	"
6/25	"
7/2	"
7/9	"
7/16	R. R.
7/23	13" @ 220'. Anhy 546'. Fsg. 1583'.
7/30	Drlg. 2958'.
8/6	Sil. 3545-55' T.D. Sm. S.O. Rng. 6".
8/13	6" @ 3550'. RUST.
8/20	T.D. 3582'. 2000 acid.
	OVER

1937

8/25

6" @ 3550'

Sil 3545'

TD 3582'

2000 acid

P.- 241/18/4

224.96/4

Pot 1350

COMPLETED

KANSAS

Map No. _____ Sec. 30 Twp. 22 R. 11 ^WWell No. 7 - KomarekStanolind Company

Contractor

FIRST REPORT

330 Ft. from N. Line

_____ Ft. from S. Line

330 Ft. from E. Line

_____ Ft. from W. Line

SECTION PLAT

			o

Location ✓

Rig up _____

Drilling and Remarks:

RECORD

Cased _____ in., _____ ft.

Sand _____

Gas _____

Oil _____

Total Depth _____

PRODUCTION

1st 24 hrs. Nat. _____

1st 24 hrs. after shot. _____

Gas _____ Cu. Ft.

Dry Hole _____

Abandoned _____

Date

APR 28 1927 19

H. D. Hatfield Scout

KANSAS

Form 26-TM Bks. 2-29

Map No. _____ Sec. 30 Twp. 22 R. 11WWell No. 7-KomarekStanford Company_____
Contractor

COMPLETED

330 Ft. from N. Line

____ Ft. from S. Line

330 Ft. from E. Line

____ Ft. from W. Line

SECTION PLAT

			0

Location _____

Rig up _____

Drilling and Remarks:

2000 AcidP. - 241.18 1/4224.96 1/4Pot - 1350

RECORD

Cased 6 in. 3550 ft.Sand 511 3545

Gas _____

Oil _____

Total Depth 3582

PRODUCTION

1st 24 hrs. Nat. _____

1st 24 hrs. after shot _____

Gas _____ Cu. Ft.

Dry Hole _____

Abandoned _____

Date

AUG 25 1937

19

H. D. Hatfield Scout