KANSAS


Form 51-5M 5-37 Petrol

Stafford

Section 30 Township 22 Range 11-W

Well No. 8 Komarck

Company Stanolind

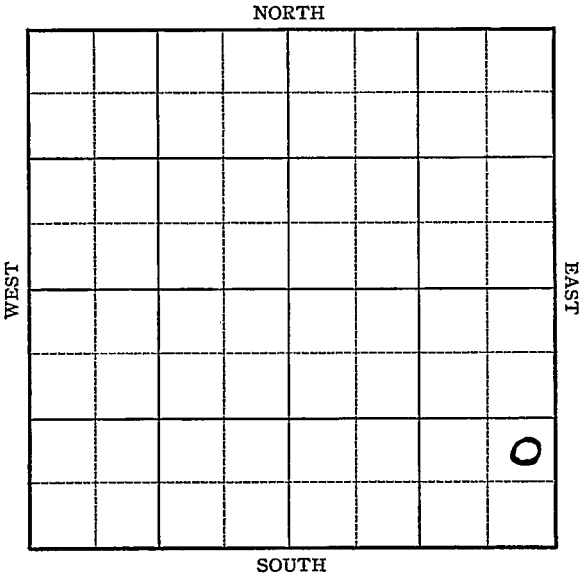


Form 252-A—5M—2-37—Palace Stafford KANSAS

Sec. 30 Twp. 22 R. 11-W

Well No. #8 Komarek Farm

Stanolind Company

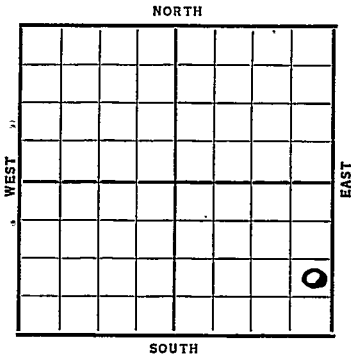

____ Ft. from N. Line

990 Ft. from S. Line

330 Ft. from E. Line

____ Ft. from W. Line

Elev. 1816

Date	REPORT
1937	
8/4	Mov. in Tools.
8/13	13" @ 220'. Anhy 544'.
	Drlg. 1681'.
8/20	Drlg. 3128'.
8/28	Sil. & 6" @ 3523'.
	T.D. 3532'. WOC.
9/3	" " "
9/10	" " "
9/17	" " "
9/24	T.D. 3542'. 2500' oil.
	Coring.

OVER

1937

9/29 6" @ 3523'.

Sil. 3523'.

T.D. 3546'.

2000 acid.

Pot. 1382 bbls.

COMPLETED

Form 26—1M Bks.—2-29 Stafford KANSAS

Map No. Sec. 30 Twp. 22 R. 11 W.


Well No. 8- Komarek

Standlind Company

Contractor

FIRST REPORT

SECTION PLAT

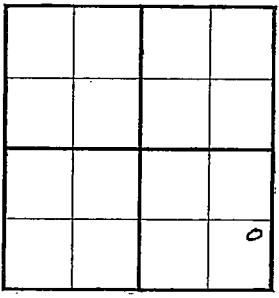

____ Ft. from N. Line

990 Ft. from S. Line

330 Ft. from E. Line

____ Ft. from W. Line

Location

Rig up

Drilling and Remarks:

Mov. in. Tools

RECORD

Cased ____ in., ____ ft.

Sand

Gas

Oil

Total Depth

PRODUCTION

1st 24 hrs. Nat.

1st 24 hrs. after shot

Gas Cu. Ft.

Dry Hole

Abandoned

Date

AUG 4 - 1937 19

H. D. Hatfield Scout

Form 26—1M Bks.—2-29

Stafford KANSAS

Map No. _____ Sec. 30 Twp. 22 R. 11W

Well No. 8-Komarek

Stanolind Company

Contractor

COMPLETED

NE SE SE


_____ Ft. from N. Line

990 Ft. from S. Line

330 Ft. from E. Line

_____ Ft. from W. Line

SECTION PLAT

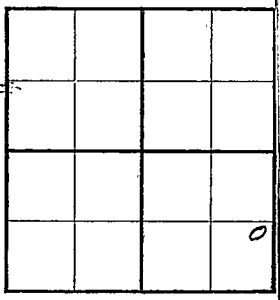

Location _____

Rig up _____

Drilling and Remarks:

2000 acid

Pot 1382

RECORD

Cased 6 in., 3523 ft.

~~Sand~~ Oil 3523

Gas _____

Oil _____

Total Depth 3546

PRODUCTION

1st 24 hrs. Nat. _____

1st 24 hrs. after shot _____

Gas _____ Cu. Ft.

Dry Hole _____

Abandoned _____

Date

SEP 29 1937 19____ H. D. Hatfield Scout