


Stafford KANSAS

Form 51-5M 5-37 Petrol

Section 30 - Township 22 Range 11-W

Well No. #12 Komarek

Company Stanolind

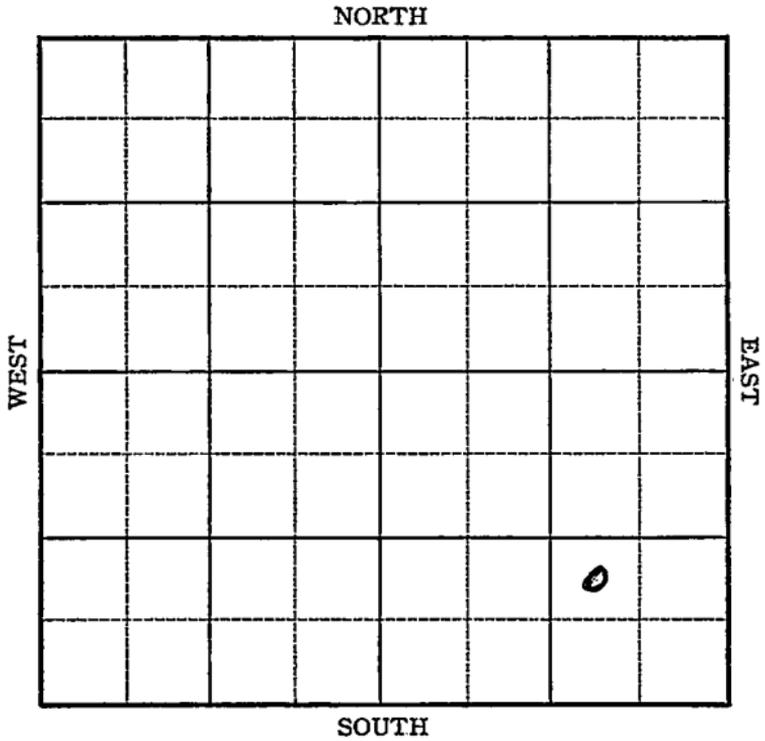

Sec. 30 Twp. 22 R. 11-W

Well No. #12 Komarek Farm

Starolind Company


           Ft. from N. Line

990 Ft. from S. Line

990 Ft. from E. Line

           Ft. from W. Line

Elev. 1818

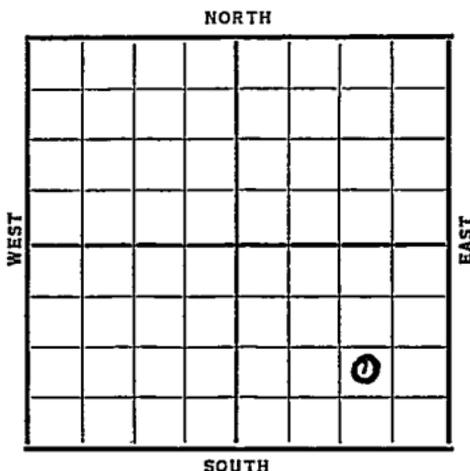

Date	REPORT
1937	
9/22	Cellar.
10/2	R. R.
10/8	"
10/15	13" @ 220'. WOC.
10/22	Anhy 546'. Drl g. 2593'.
10/29	Sil. 3530'. No shows.
	Coring.
11/5	6" @ 3530'. T.D. 3533'. RUST.
	No shows.
11/12	T.D. 3535'. 2000' oil.
11/17	6" @ 3530'.
	Sil. 3530'.
	T.D. 3560'.
	Potential 1698 bbls.
	COMPLETED

*Stafford*

KANSAS

Map No. \_\_\_\_\_ Sec. 30 Twp. 22 R. 112d

Well No. 12 Komarek

Stanelind Company

Contractor \_\_\_\_\_

**FIRST REPORT**

**SECTION PLAT**

\_\_\_\_\_ Ft. from N. Line

990 Ft. from S. Line

990 Ft. from E. Line

\_\_\_\_\_ Ft. from W. Line

			○

Location \_\_\_\_\_

Rig up \_\_\_\_\_

Drilling and Remarks:

*Cellar*

**RECORD**

Cased \_\_\_\_\_ in., \_\_\_\_\_ ft.

Sand \_\_\_\_\_

Gas \_\_\_\_\_

Oil \_\_\_\_\_

Total Depth \_\_\_\_\_

**PRODUCTION**

1st 24 hrs. Nat. \_\_\_\_\_

1st 24 hrs. after shot \_\_\_\_\_

Gas \_\_\_\_\_ Cu. Ft.

Dry Hole \_\_\_\_\_

Abandoned \_\_\_\_\_

Date

SEP 22 1937 19

H. D. Hatfield Scout

Stafford **KANSAS**Map No. \_\_\_\_\_ Sec. 30 Twp. 22 R. 11WWell No. 12 Komarek\_\_\_\_\_ Stanolind Oil \_\_\_\_\_ Company

\_\_\_\_\_ Contractor

**COMPLETED**

NW SE SE

\_\_\_\_\_ Ft. from N. Line

990 Ft. from S. Line990 Ft. from E. Line

\_\_\_\_\_ Ft. from W. Line

**SECTION PLAT**

			6

Location \_\_\_\_\_

Rig up \_\_\_\_\_

Drilling and Remarks:

POT-1698**RECORD**Cased 6 in., 3530 ft.Sand sil 3530

Gas \_\_\_\_\_

Oil \_\_\_\_\_

Total Depth 3560**PRODUCTION**

1st 24 hrs. Nat. \_\_\_\_\_

1st 24 hrs. after shot \_\_\_\_\_

Gas \_\_\_\_\_ Cu. Ft.

Dry Hole \_\_\_\_\_

Abandoned \_\_\_\_\_

Date

NOV 17 1937 19 \_\_\_\_\_ H. D. Hatfield Scout