Form 51-5M 5-37 Petrol


Staffard

KANSAS

Section 30 Township 22 Range 11-W

Well No. 9 - Komarek

Company Stanolind

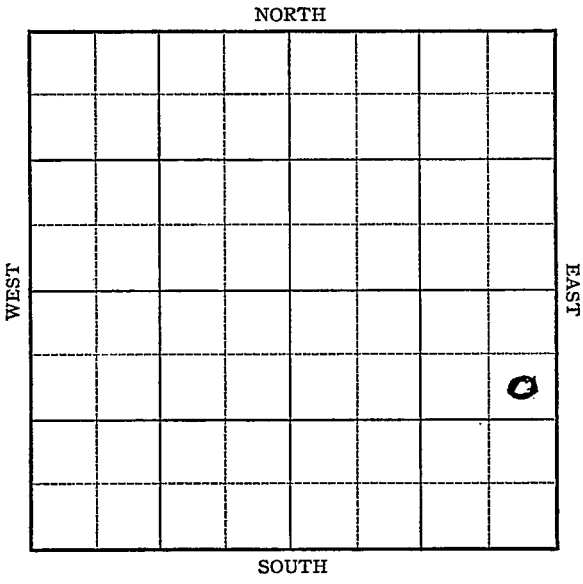

Form 252-A—5M—2-37—Palace KANSAS STAFFORD

Sec. 30 Twp. 22 R. 11W

Well No. #9 Komarek Farm


Stanolind Company

990 Ft. from N. Line

Ft. from S. Line

330 Ft. from E. Line

Ft. from W. Line

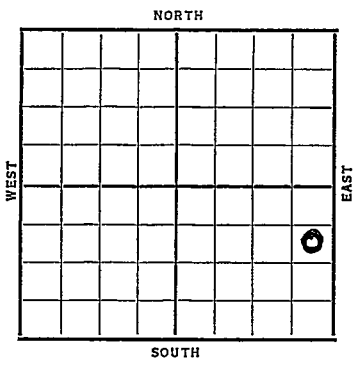

Elev. 1820

Date	REPORT
1937	
8/25	B.R.R.
9/3	13" @ 218'. Drlg. 350'.
9/10	Drlg. 2656'.
9/17	Drlg. 3520'.
9/24	Sil. 3522'. 6¾ @ 3523'.
	RUST.
10/2	T.D. 3542'. 3400' oil.
10/6	6" @ 3523'.
	Sil. 3522'.
	T.D. 3553'.
	Potential 1275 bbls. Nat.
	COMPLETED

Form 26—1M Bks.—2-29

Stafford KANSAS

Map No. _____ Sec. 30 Twp. 22 R. 11W


Well No. 9 - Komarek

Stanolind Company

FIRST REPORT Contractor

se ne se

SECTION PLAT

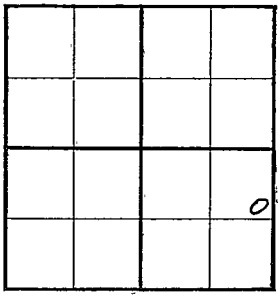

990 Ft. from N. Line

_____ Ft. from S. Line

330 Ft. from E. Line

_____ Ft. from W. Line

Location _____

Rig up _____

Drilling and Remarks:

B. R. R.

RECORD

Cased _____ in., _____ ft.

Sand _____

Gas _____

Oil _____

Total Depth _____

PRODUCTION

1st 24 hrs. Nat. _____

1st 24 hrs. after shot _____

Gas _____ Cu. Ft.

Dry Hole _____

Abandoned _____

Date

AUG 25 1937 19____

H. D. Hatfield Scout

Form 26—1M Bks.—2-29 Stafford KANSAS

Map No. Sec. 30 Twp. 22 R. 11W

Well No. 9 Komarek

Stanolind Company

Contractor

COMPLETED

SE NE SE


990 Ft. from N. Line

Ft. from S. Line

330 Ft. from E. Line

Ft. from W. Line

SECTION PLAT

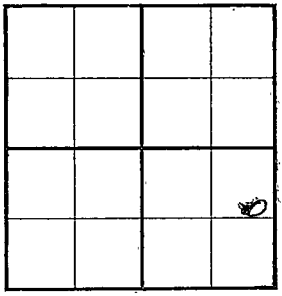

Location

Rig up

Drilling and Remarks:

P&T-1275

Nat.

RECORD

Cased 6 in., 3523 ft.

~~Sand~~ Sil 3522

Gas

Oil

Total Depth 3553

PRODUCTION

1st 24 hrs. Nat.

1st 24 hrs. after shot

Gas Cu. Ft.

Dry Hole

Abandoned

Date

OCT - 6 1937 19

H. D. Hatfield Scout