

Stafford


KANSAS

Form 51-5M 5-37 Petrol

Section 30 Township 22 Range 11-W


Well No. #11 Komarek

Company Stanolind

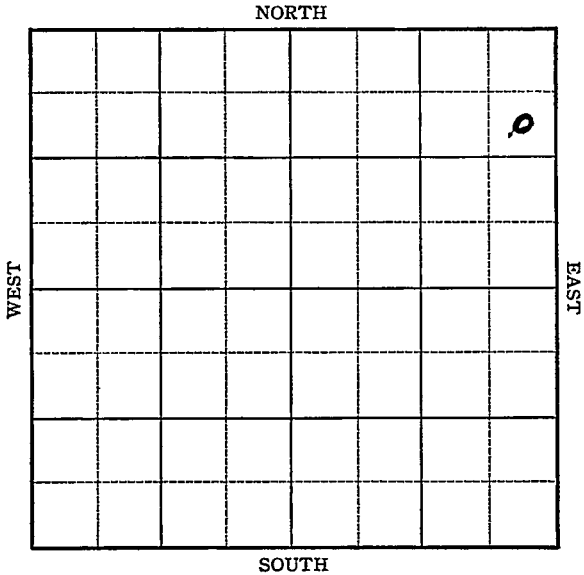

Sec. 30 Twp. 22 R. 11-WWell No. #11 Komarek FarmStanolind Company990 Ft. from N. Line Ft. from S. Line330 Ft. from E. Line Ft. from W. Line

Elev. 1833

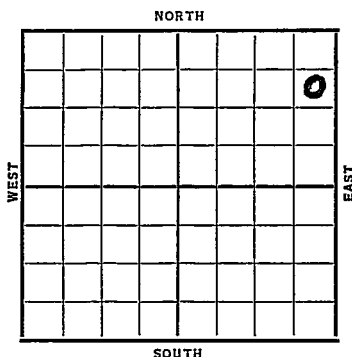

Date	REPORT
1937	
9/22	R. Rig.
10/2	R U R
10/8	13" @ 227'. Anhy 568'.
	Drlg. 1995'.
10/15	Drlg. 3310'.
10/22	Sil. 3577-80' T.D. S.O.
	6" @ 3576'. RUST.
10/29	" " " "
11/5	Correction 3580' equals 3570'.
	Sil. 3567'. 6" @ 3566'
	(Corrected)
	Deepened to 3580' T.D. 3400'.
	oil. 2000 acid. Swabbing.
11/10	6" @ 3566'.
	Sil. 3567'.
	T.D. 3580'.
	2000 acid.
	Potential 1064 bbls.
	COMPLETED

KANSAS

Map No. _____ Sec. 30 Twp. 22 R. 1125Well No. 11 KomarekStanolind Company

Contractor _____

FIRST REPORT

SECTION PLAT

990 Ft. from N. Line

_____ Ft. from S. Line

330 Ft. from E. Line

_____ Ft. from W. Line

			0

Location _____

Rig up _____

Drilling and Remarks:

P. Rig

RECORD

Cased _____ in., _____ ft.

Sand _____

Gas _____

Oil _____

Total Depth _____

PRODUCTION

1st 24 hrs. Nat. _____

1st 24 hrs. after shot _____

Gas _____ Cu. Ft.

Dry Hole _____

Abandoned _____

Date

SEP 22 1937

H. D. Hatfield Scout

Stafford. KANSAS

Map No. _____ Sec. 30 Twp. 22 R. 11WWell No. 11 KomarekStanolind Oil

Company

Contractor

SECTION PLAT

			0

SE NE NE

990 Ft. from N. Line

Ft. from S. Line

330 Ft. from E. Line

Ft. from W. Line

Location _____

Rig up _____

Drilling and Remarks:

2000 AcidPOT 1064

RECORD

Cased 6 in., 3566 ft.Sand sil 3567

Gas _____

Oil _____

Total Depth 3580

PRODUCTION

1st 24 hrs. Nat. _____

1st 24 hrs. after shot _____

Gas _____ Cu. Ft.

Dry Hole _____

'Abandoned _____

Date

NOV 10 1937

19

H. D. Hatfield Scout