


Section 30 Township 22 Range 11-W

Well No. 13 Komarek

Company Stanolind

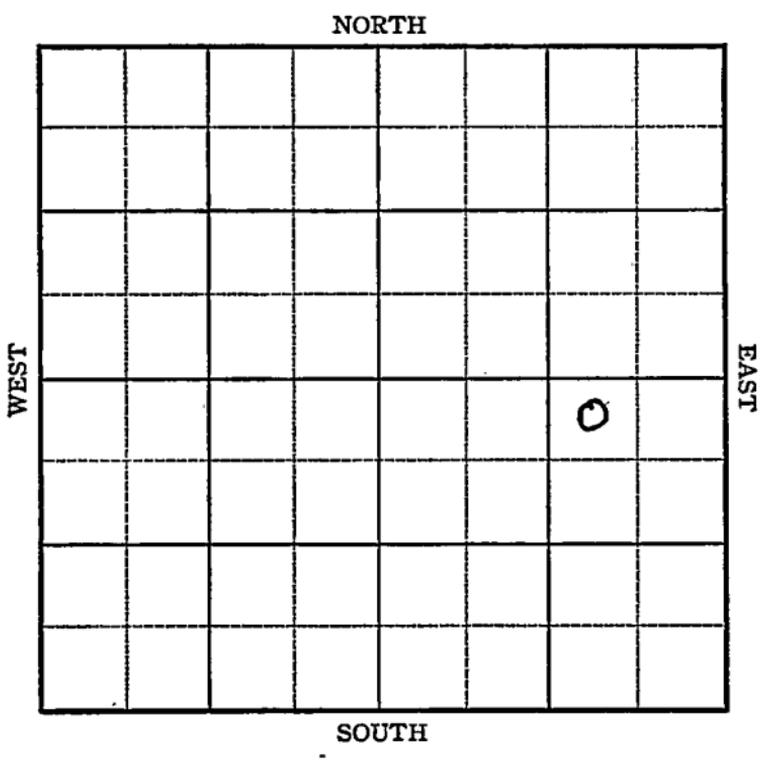

Sec. 30 Twp. 22 R. 11-W

Well No. #13 Komarek Farm

Stanolind Company


330 Ft. from N. Line

_____ Ft. from S. Line

990 Ft. from E. Line

_____ Ft. from W. Line

Elev. 1819

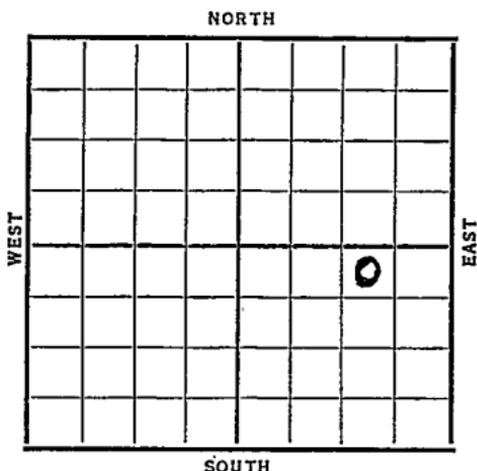

Date	REPORT
1937	
10/6	R. R.
10/15	13" @ 233'. Drlg. 1560'.
10/22	Drlg. 3220'.
10/29	Sil. 3533'. T.D. 3539'.
	7" @ 3533'. RUST.
	No shows reported.
11/5	T.D. 3552'. H.F.O.
11/10	6" @ 3533'.
	Sil. 3533'.
	T.D. 3558'.
	Potential 1485 bbls. Nat.
	COMPLETED

Stafford KANSAS

Map No. _____ Sec. 30 Twp. 22 R. 11WWell No. 13 KomarekStanolind

Company _____

Contractor _____

NW NE SE

FIRST REPORT

SECTION PLAT

330 Ft. from N. Line

_____ Ft. from S. Line

990 Ft. from E. Line

_____ Ft. from W. Line

			0

Location _____

Rig up _____

Drilling and Remarks:
RR

RECORD

Cased _____ in., _____ ft.

Sand _____

Gas _____

Oil _____

Total Depth _____

PRODUCTION

1st 24 hrs. Nat. _____

1st 24 hrs. after shot _____

Gas _____ Cu. Ft.

Dry Hole _____

Abandoned _____

Date

6 - 6 1937

19

H. D. Hatfield

Scout

Stafford KANSAS

Map No. 46 Sec. 30 Twp. 22 R. 11W

Well No. 13 Komarek

Stanolind Company

~~COMPLETED~~ Contractor

SECTION PLAT

330 NW NE SE
Ft. from N. Line
____ Ft. from S. Line
990 Ft. from E. Line
____ Ft. from W. Line

			0

Location _____

Rig up _____

Drilling and Remarks:

*POT 1485
NAT*

RECORD

Cased 6 in., 3533 ft.
Sand sil 3533
Gas _____
Oil _____
Total Depth 3558

PRODUCTION

1st 24 hrs. Nat. _____
1st 24 hrs. after shot _____
Gas _____ Cu. Ft.
Dry Hole _____
Abandoned _____

Date

NOV 10 1937 19 F. D. Hatfield Scout