


Section 30 Township 22 Range 11-W


Well No. 15 Komarek

Company Stanolind

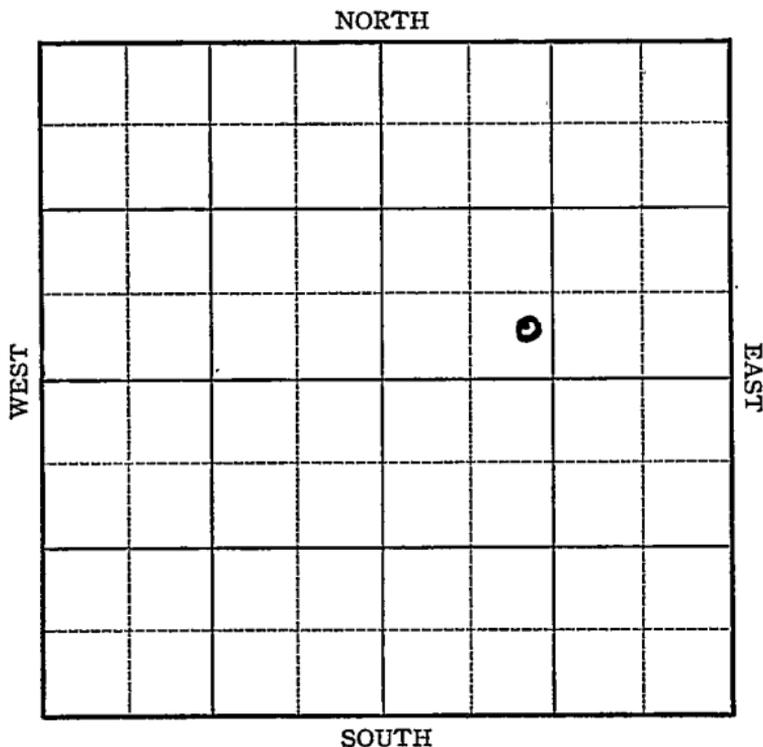

Sec. 30 Twp. 22 R. 11-WWell No. #15 Komarek Farm
Stanolind Company Ft. from N. Line330 Ft. from S. Line Ft. from E. Line1090 Ft. from W. Line

Elev. 1821

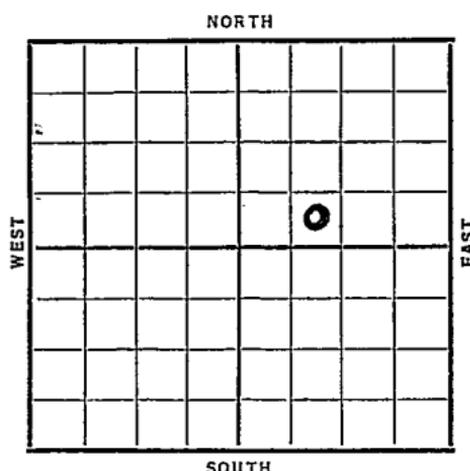

Date

REPORT

1937

12/1 B. R. R.

12/10 S. H.

12/17 13" @ 220'. Anhy 557'.

Drl g. 2330'.

12/24 Drl g. 3475'.

12/31 Arb. 3579'. T.D. 3596'.

6" @ 3580'. RUST.

No shows reported.

1938

1/7 T.D. 3596'. 3200' oil.

Swab 40 bbls. oil in 2 hrs.

1/14 2000 acid. Swab 25 bbls. oil

per hr. 3000 acid.

Swab 32 bbls. oil per hr.

OVER

1938

1/19

6" @ 3580'.

Arb. 3579'.

T.D. 3596'.

5000 acid.

Potential 686 bbls.

COMPLETED

Map No. 76 Sec. 30 Twp. 22 R. 11W

Well No. 15 Komarek

Stanofind Company

Contractor

FIRST REPORT

SECTION PLAT

SE SW NE

_____ Ft. from N. Line

330 Ft. from S. Line

_____ Ft. from E. Line

1090 Ft. from W. Line

		0	

Location _____

Rig up _____

Drilling and Remarks:

BRR

RECORD

Cased _____ in., _____ ft.

Sand _____

Gas _____

Oil _____

Total Depth _____

PRODUCTION

1st 24 hrs. Nat. _____

1st 24 hrs. after shot _____

Gas _____ Cu. Ft.

Dry Hole _____

Abandoned _____

Date

DEC 1 - 1937 19

H. D. Hatfield

Scout

Stafford KANSASMap No. 46 Sec. 30 Twp. 22 R. 11WWell No. 15 KomarekStanolind

Company

Contractor

COMPLETED

SE SW NE

_____ Ft. from N. Line

330 Ft. from S. Line

_____ Ft. from E. Line

1090 Ft. from W. Line**SECTION PLAT**

		0	

Location _____

Rig up _____

Drilling and Remarks:

5000 acidPOT 686**RECORD**Cased 6 in., 3580 ft.Sand Arb 3579

Gas _____

Oil _____

Total Depth 3596**PRODUCTION**

1st 24 hrs. Nat. _____

1st 24 hrs. after shot _____

Gas _____ Cu. Ft.

Dry Hole _____

Abandoned _____

Date

JAN 19 1938₁₉H. D. Hatfield Scout