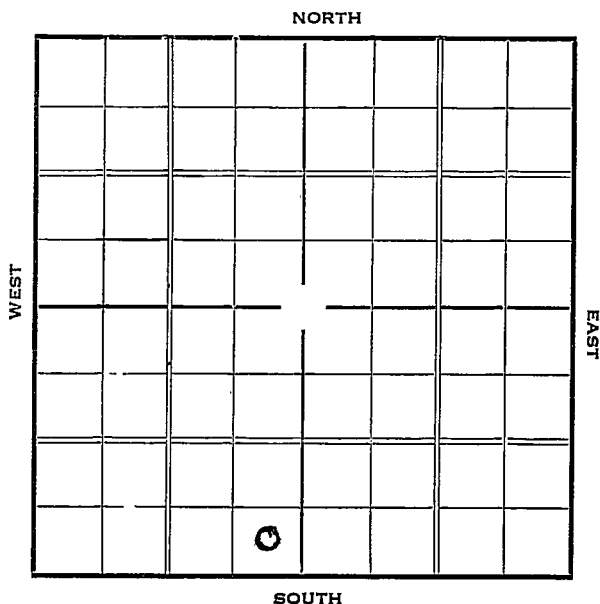


Section 30 Township 22 Range 11-WWell Number 1 NolteCompany Stanolind

KANSAS*Stafford*Map No. _____ Sec. 30 Twp. 22 R. 11WWell No. 1 No. 1Stanford Company

Contractor _____

SECTION PLAT

_____ Ft. from N. Line

300 Ft. from S. Line300 Ft. from E. Line

_____ Ft. from W. Line

FIRST REPORT

Location _____

Rig up _____

Drilling and Remarks:

*ROG***RECORD**

Cased _____ in., _____ ft.

Sand _____

Gas _____

Oil _____

Total Depth _____

PRODUCTION

1st 24 hrs. Nat. _____

1st 24 hrs. after shot _____

Gas _____ Cu. Ft.

Dry Hole _____

Abandoned _____

Date

APR 7 1937 19

S. J. LEWIS

Scout

Stafford KANSAS

Map No. 46 Sec 30 Twp. 22 R. 11 WWell No. 1 - WalterStanolind Company

Contractor

ABANDONED

SECTION PLAT

0

_____ Ft. from N. Line

330 Ft. from S. Line330 Ft. from E. Line

_____ Ft. from W. Line

Location _____

Rig up _____

Drilling and Remarks:

D & A

RECORD

Cased _____ in., _____ ft.

Sand 511 3660

Gas _____

Oil _____

Total Depth 3691

PRODUCTION

1st 24 hrs. Nat. _____

1st 24 hrs. after shot _____

Gas _____ Cu. Ft.

Dry Hole _____

Abandoned _____

Date

JUN 9 1937 19

H. D. Hatfield

Scout