


Section 30 Township 22 Range 11W

Well No. #1 Nolte

Company Anderson-Prichard

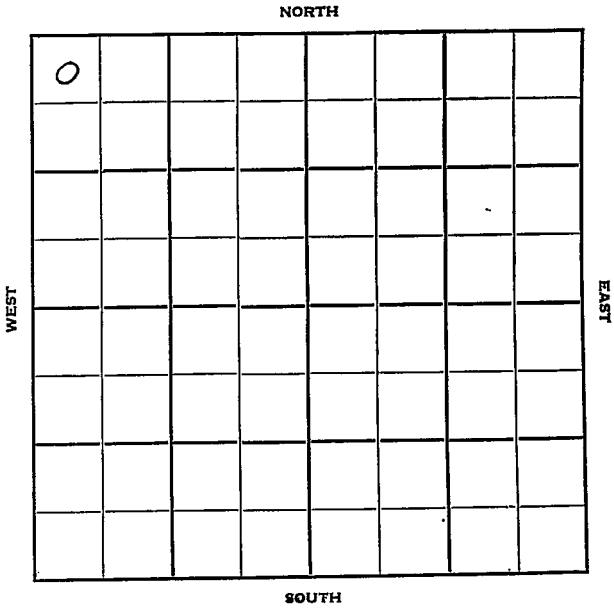

Stafford

KANSAS

Sec. 30 Twp. 22 R. 11W

Well No. #1 Nolte Farm

Anderson-Prichard Company

B & B Contractor


330 Ft. from N. Line

 Ft. from S. Line

 Ft. from E. Line

330 Ft. from W. Line

NW NW NW

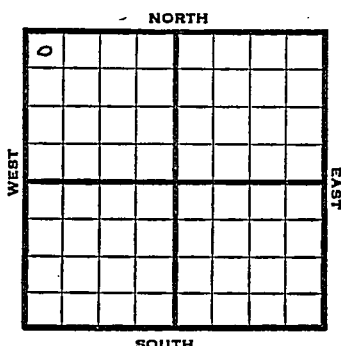

1951

Elev. 1849' REPORT

10/31

Spud 10-25-51

8" @ 252'

Drlg. 2270'

12/5

Spud 10-25-51

Oil well TD 3666' 8" @ 252'

Heeb 3123' Br. lime 3259'

Lans. 3286'

DST 3429-46 open $\frac{1}{2}$ hr. rec 15' mud

DST 3448-55 open 45 min. rec 60' mud
& SW, 200' SW

Viola 3563'

DST 3559-75 open $\frac{1}{2}$ hr. rec 5' mud

Simp. sh. 3606' Sand 3629'

DST 3630-36 open 35 min. rec 5' mud
Arb. 3663'

DST 3660-66 open $\frac{1}{2}$ hr. rec 120' HOCM
1128' oil.

TD 3666' 5" @ 3664' CO to 3666'

S/100 BO 11 BW 8 hr.

Comp. 124 BOPD 21% water.

COMPLETED

County Stafford State KansasSec. 30 (Blk. Twp.) 22 (Sur. Rge.) 11W Map No.Operator Anderson PrichardWell No. 1 Farm NolteElev. Location NW NW NW

0							

330 Ft. From N Line NW330 Ft. From W Line QuarterIst. Report OCT 31 1951

Completion

Remarks

B & B - Contr.Spudding Date 10-25-51

Drlg. Data

8" @ 252 Drlg. 2270

J. E. TYRA

County Stafford State KansasSec. 30 (Blk. 22) (Sur. 11W) Map No.Operator Anderson-PrichardWell No. 1 Farm NolteElev. 1849 Location NW NW NW

0							

330 Ft. From N Line NW330 Ft. From W Line Quarter

1st. Report

Completion DEC 5 1951

Remarks

B & B Drilg. - Contr.Spudding Date 10-25-51Drilg. Data Oil well TD 36668" @ 252 Heeb. 3123 Br. lime 3259Lans. 3286 DST 3429-46 open $\frac{1}{2}$ hr.Rec. 15' mud DST 3448-55 open 45 min.Rec. 60' mud & sw 200' sw Viola 3563DST 3559-75 open $\frac{1}{2}$ hr. Rec. 5' mudSimp. sh. 3606 sand 3629 DST 3630-36open 35 min. Rec. 5' mud Arb. 3663DST 3660-66 open $\frac{1}{2}$ hr. Rec. 120' hoem1128' oil TD 3666 5" @ 3664 CO to 3666S/ 100 bo 11 bw 8 hr.Comp. 124 bopd 21% water

J. E. TYRA