




*Harvey*

Map No. KANSAS Sec. 30 Twp. 22 R. 30

Well No. 3 Klassen Farm  
Mid-Kansas Company

330 Ft. from N. Line  
\_\_\_\_ Ft. from S. Line  
990' Ft. from E. Line  
\_\_\_\_ Ft. from W. Line

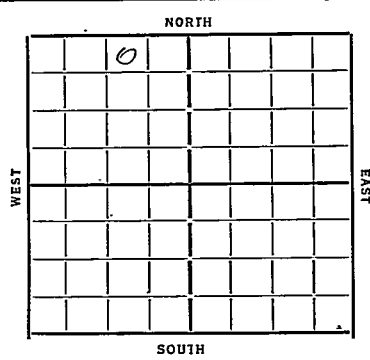

Date	REPORT
1933	
12/27	Bldg Rig
1/4	15" at 441
1/11	wreg 1935
1/17	" 2800
1/24	Chat 3145
	Hunter 3325
	8" at 3325
	TD 3327 RUST
1/31	TD 3356 1800' oil 12 hrs.
2/7	Top Viola 3464 9. Wilson
	3490 S.O. 3494-96 TD 3552
	Cmty 5"
2/14	5" 3543 TD 3556 Est 15 Bbls
	per hr swab
2/23	Siliceous 3592 swab
	10 Bbls per hr Dily 3662
3/1	75 3460 Plug back
3/8	PB 3355 acidizing
3/15	Pump 500 Bbls 24 hrs.
3/21	Wilson 3490 75 3460 PB
	3355 702 Bbls.

**COMPLETED**

Map No. 43 Sec. 30 Twp. 22 R. 3W  
 Well No. 3-Klassen  
Mid-Kas Company  
 OIL FIELD REPORTS  
 Contractor

SECTION PLAT

330 Ft. from N. Line  
 ..... Ft. from S. Line  
990 Ft. from E. Line  
 ..... Ft. from W. Line

	0		

Location.....  
 Rig up.....  
 Drilling and Remarks:

BK.

RECORD

Cased.....in., .....ft.  
 Sand.....  
 Gas.....  
 Oil.....  
 Total Depth.....

PRODUCTION

1st 24 hrs. Nat.....  
 1st 24 hrs. after shot.....  
 Gas.....Cu. Ft.  
 Dry Hole.....  
 Abandoned.....

Date

12-27-33 192

O. Manschreck Scout

*Harvey*  
 Map No. 43 Sec. 30 Twp. 22 R. 3W

Well No. 3-Klassen  
Mid-Kansas Company

Contractor

**COMPLETED**

## SECTION PLAT

	0		

330 Ft. from N. Line

\_\_\_\_\_ Ft. from S. Line

990 Ft. from E. Line

\_\_\_\_\_ Ft. from W. Line

Location \_\_\_\_\_

Rig up \_\_\_\_\_

Drilling and Remarks:

P. B. 3355702 bbls

## RECORD

Cased \_\_\_\_\_ in., \_\_\_\_\_ ft.

Sand Water 3490

Gas \_\_\_\_\_

Oil \_\_\_\_\_

Total Depth 3760

## PRODUCTION

1st 24 hrs. Nat. \_\_\_\_\_

1st 24 hrs. after shot \_\_\_\_\_

Gas \_\_\_\_\_ Cu. Ft.

Dry Hole \_\_\_\_\_

Abandoned \_\_\_\_\_

Date

3/21/34 19 O. Mannschreck Scout