


Harvey
3w

Map No. KANSAS Sec. 30 Twp. 22 R. 3w

Well No. 4 Klassen Farm
Marathon Oil Company

NORTH

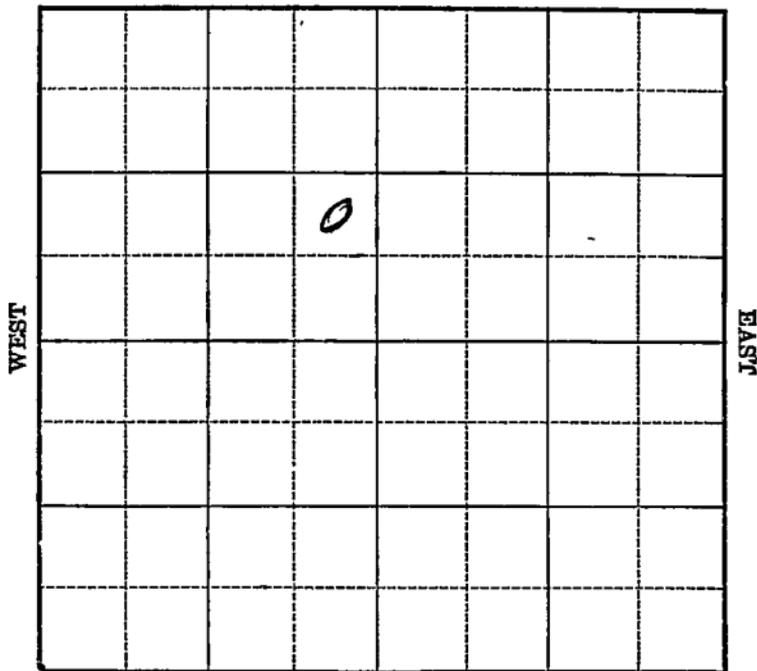

SOUTH

Location _____

Drilling Remarks _____

Rig Up _____

Drilling Remarks _____

RECORD

Cased _____ in. _____ ft.

Sand _____

Gas _____

Oil _____

Total Depth _____

PRODUCTION

1st 24 hrs. Nat. _____

1st 24 hrs. after shot _____

Gas _____ cu. ft.

Dry Hole _____

Abandoned _____

Harvey

Map No. KANSAS Sec. 30 Twp. 22 R. 3W


Well No. 4 Klassen Farm
Marathon Oil Company

_____ Ft. from N. Line

990 Ft. from S. Line

330 Ft. from E. Line

_____ Ft. from W. Line

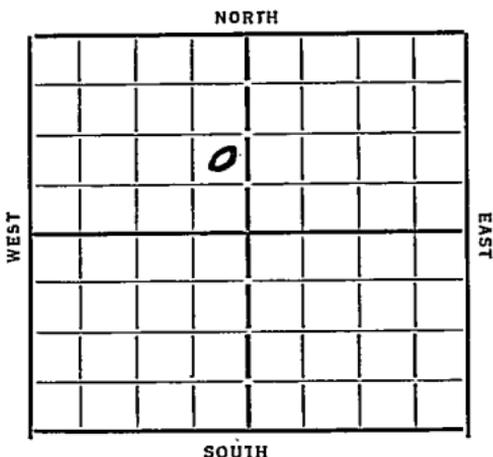

Date 1934

REPORT

<u>10/24</u>	<u>Location</u>	
<u>11/1</u>	<u>Dly 494</u>	<u>12" 467</u>
<u>11/8</u>	<u>" 2300</u>	
<u>11/15</u>	<u>" 3100</u>	
<u>11/22</u>	<u>T Chat 3166</u>	<u>8" 3166</u>
	<u>Show Gas 3170-72</u>	
<u>11/28</u>	<u>Inc Gas 3172-90</u>	
	<u>Oil 3212-25 517</u>	
<u>12/6</u>	<u>flow 820 Bbls 23 hrs.</u>	
<u>12/12</u>	<u>Chat 3166 T17 3225</u>	
	<u>816 Bbls.</u>	

COMPLETED

Map No. 43 Sec. 30 Twp. 22 R. 3W

Well No. 4 - Klassen

Marathon oil Company

Contractor

SECTION PLAT

FIRST REPORT

 Ft. from N. Line

990 Ft. from S. Line

330 Ft. from E. Line

 Ft. from W. Line

	0		

Location

Rig up

Drilling and Remarks:

RECORD

Cased in., ft.

Sand

Gas

Oil

Total Depth

PRODUCTION

1st 24 hrs. Nat.

1st 24 hrs. after shot

Gas Cu. Ft.

Dry Hole

Abandoned

Date

10-24-34 19

ORVAL MANNSCHRECK
Scout

Map No. 43 Sec. 30 Twp. 22 R. 3W

Well No. 4-Klassen

Marathon Oil Company

Contractor

COMPLETED

SECTION PLAT

	0		

.....Ft. from N. Line

990 Ft. from S. Line

330 Ft. from E. Line

.....Ft. from W. Line

Location.....

Rig up.....

Drilling and Remarks:

816 bbls

RECORD

Cased..... in., ft.

Sand *Chat 3166*

Gas.....

Oil.....

Total Depth. 3225

PRODUCTION

1st 24 hrs. Nat.....

1st 24 hrs. after shot.....

Gas..... Cu. Ft.

Dry Hole.....

Abandoned.....

Date

12-12-37 192.....

ORVAL MANNSCHRECK

Scout