


Harvey **KANSAS**

Section 30 Township 22 Range 3W

Well No. #1 Frantz

Company Brunson

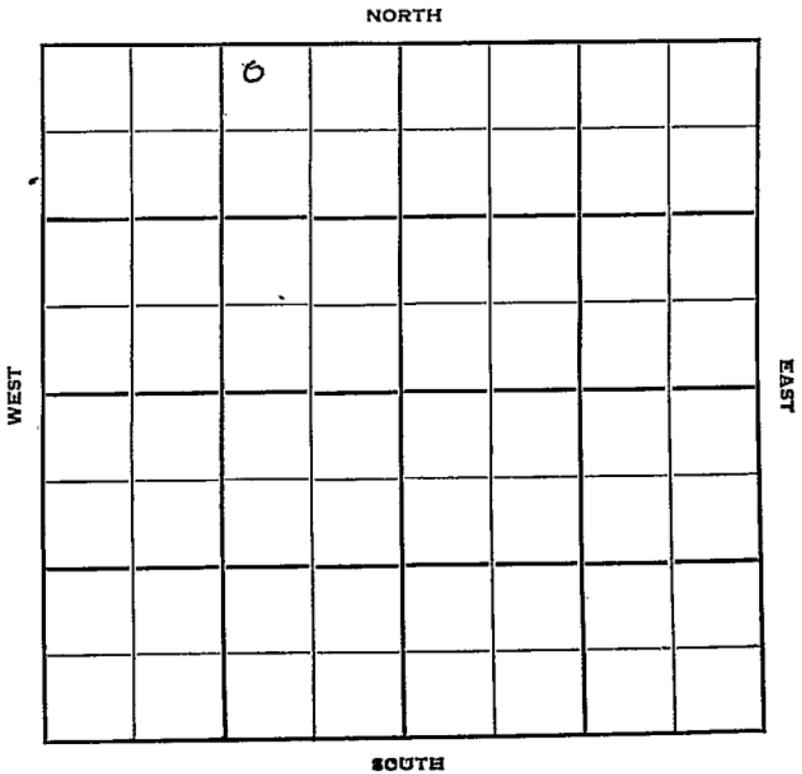

Sec. 30 Twp. 22 R. 3-W ✓

Well No. #1 Frantz Farm

Brunson Company

Contractor

Miscellaneous


_____ Ft. from N. Line

_____ Ft. from S. Line

_____ Ft. from E. Line

_____ Ft. from W. Line

15' South & 50' East
of Old Well
NW NE NW

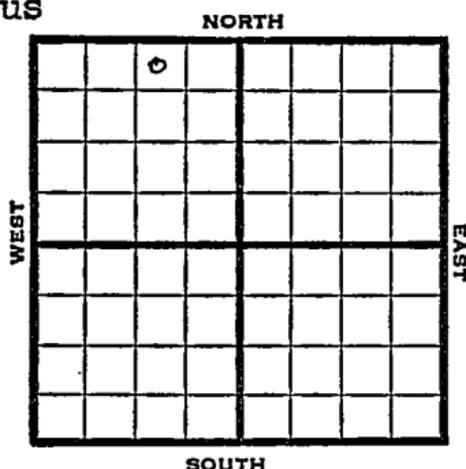

1950 Elev 1446' REPORT

2/15 Spud 2-11-50
8"@ 297'
Drlg 940'

4/19 TD 3580'
8"@ 297'
Lans 2487'
Miss 3142'
Kinderhook 3223'
Misener 3328'
Hunton 3322'
Mag 3411'
Viola 3465'
Simp 3489'
5"@ 3540'
Arb. 3564-80 ED
PB to KG 2580'
24/2504-10
500 acid sso
D&A
Aband.

ABANDONED

Map No. _____ Sec. 30 Twp. 22 R. 3W

Well No. 1 Frantz

_____ Brunson _____ Company

_____ Contractor

NW NE NW

15' South & 50' East
of old well

_____ Ft. from N. Line

_____ Ft. from S. Line

_____ Ft. from E. Line

_____ Ft. from W. Line

SECTION PLAT

	0		

FIRST REPORT

Harvey County

Location _____

Rig up _____

Drilling and Remarks:

Spud 2-11-50

8" @ 297

drlg. 940

RECORD

Cased _____ in., _____ ft.

Sand _____

Gas _____

Oil _____

Total Depth _____

PRODUCTION

1st 24 hrs. Nat. _____

1st 24 hrs. after shot _____

Gas _____ Cu. Ft.

Dry Hole _____

Abandoned _____

Date


FEB 15 1950 19

J. E. TYRA Scout

Map No. _____ Sec. 30 Twp. 22 R. 3WWell No. 1 Frantz_____
Brunson Drlg. _____ CompanyE. 1446 Contractor

NW NE NW 15' S & 50' E of old well

SECTION PLAT

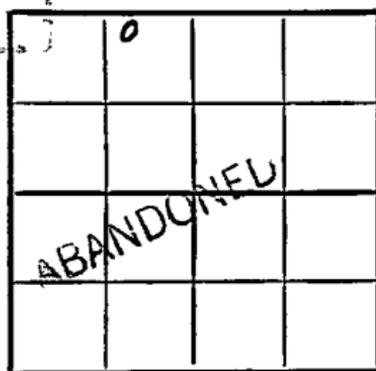Ft. from N. Line_____
Ft. from S. Line_____
Ft. from E. Line_____
Ft. from W. Line

Harvey County

Location _____

Rig up _____

Drilling and Remarks:

8" C 297
 Kans. 2487
 Miss. 3142
 Kinderhook 3223
 Misener 3328
 Hurton 3322
 Max. 3411
 Uick 3465
 Simp 3489

Date _____

RECORD

Cased _____ in., _____ ft.

Sand _____

Gas _____

Oil _____

Total Depth ~~3580~~ 3580

PRODUCTION

1st 24 hrs. Nat. _____

1st 24 hrs. after shot _____

Gas _____ Cu. Ft.

Dry Hole _____

Abandoned _____

APR 19 1950

19

J. E. TYRA

Scout

REF.

5" C 3540

arb. 3564-80 T.D.

P.B. to K.C. 2580

24/2504-10

500 acid : sso

D+A

INDIA







APR 28

1950

- Scout Cards *J. Smith*
- Land Small Map *J. Smith*
- Land-Wall Map *J. Smith*
- Tracings
- France Map
- Pierce Map
- Misc.


