

Section 30 Township 22 Range 3-W

Well No. #1 Schmidt

Company Coppinger & Southern
Hollow - Nickle

NORTH

							0

WEST

EAST

SOUTH

Sec. 30 Twp. 22 R. 3W

Well No. #1. Schmidt Farm

Coppinger & Southern Company

Hollow-Nickle (Coppinger, Contr.)


NORTH

990¹ Ft. from N. Line

_____ Ft. from S. Line

330¹ Ft. from E. Line

_____ Ft. from W. Line

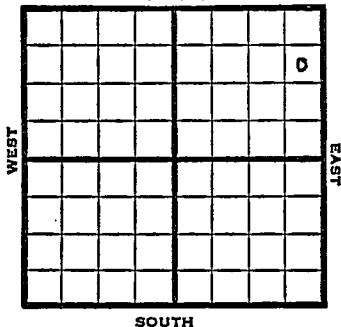

SE NE NE

SOUTH

1949 REPORT

11/23

8" @ 317'

Drlg. 2594'

11/29

Drlg 3305'

12/7

TD 3400'

Miss 3194'

Aband.

ABANDONED

Map No. _____ Sec. 30 Twp. 22 R. 3W

Well No. 1 Schmidt

_____ Coppinger & Southern _____ Company

_____ Coppinger _____ Contractor

SE NE NE

**FIRST REPORT
SECTION PLAT**

_____ 990 Ft. from N. Line

_____ Ft. from S. Line

_____ 330 Ft. from E. Line

_____ Ft. from W. Line

			e

Harvey County

Location _____

Rig up _____

Drilling and Remarks:

8" @ 317

drlg. 2594

RECORD

Cased _____ in., _____ ft.

Sand _____

Gas _____

Oil _____

Total Depth _____

PRODUCTION

1st 24 hrs. Nat. _____

1st 24 hrs. after shot _____

Gas _____ Cu. Ft.

Dry Hole _____

Abandoned _____

Date

NOV 23 1927 19

S. J. LEWIS

Scout

Kansas

Map No. _____ Sec. 30 Twp. 22 R. 3WWell No. 1 Schmidt

Coppinger & Southern Company

ABANDONED Contractor

SE NE NE

SECTION PLAT

990 Ft. from N. Line

_____ Ft. from S. Line

330 Ft. from E. Line

_____ Ft. from W. Line

			a

Harvey County

Location _____

Rig up _____

Drilling and Remarks:

Miss 8194

RECORD

Cased _____ in., _____ ft.

Sand _____

Gas _____

Oil _____

Total Depth 3400

PRODUCTION

1st 24 hrs. Nat. _____

1st 24 hrs. after shot _____

Gas _____ Cu. Ft.

Dry Hole _____

Abandoned _____

Date

DEC 7 1949

19

S. J. LEWIS

Scout