

Harvey


Form 51-5M-11-31-Palace

Map No. **KANSAS** Sec. **30** Twp. **22** R. **3^w**

Well No. **5 Schmidt** Farm

Magnolia Company

NORTH

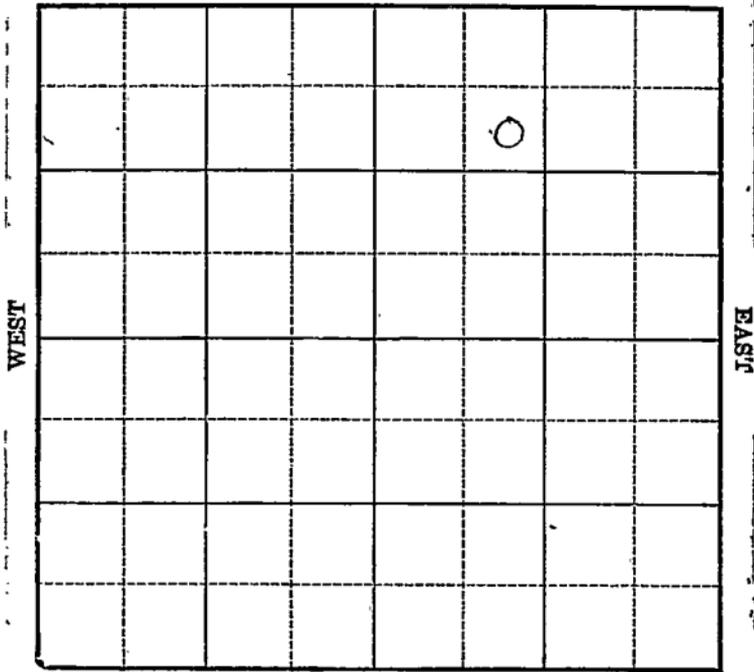

SOUTH

O. W. D. D

Location _____

Drilling Remarks _____

Rig Up _____

Drilling Remarks _____

RECORD

Cased _____ in. _____ ft.

Sand _____

Gas _____

Oil _____

Total Depth _____

PRODUCTION

1st 24 hrs. Nat. _____

1st 24 hrs. after shot _____

Gas _____ cu. ft.

Dry Hole _____

Abandoned _____

Harvey

KANSAS

Map No. _____ Sec. 30 Twp 22 R. 3W

Well No. 5 Schmidt Farm _____


Magnolia Company _____

990 Ft. from N. Line

_____ Ft. from S. Line

_____ Ft. from E. Line

990 Ft. from W. Line

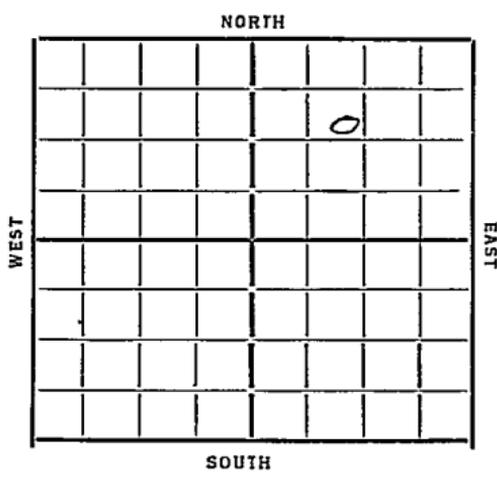

Date 1934 REPORT O. W. D. D

1/17 location
1/24 R.O.C.
1/31 Bldg Rig
2/19 Drg 750
2/14 " 2090
2/23 Plug Back to 1500
3/1 _____
3/8 Drg 2260
3/15 " 2830
3/22 " 3348 Chat 3132
3/29 7" 3366 TD 3371 Hutton 3365
4/5 Drg 3402
4/12 TD 3403 1000 Gal acid
4/19 Drg 3529 T Viola 3508
4/25 Viola 3508 TD 3549
439 B.B.L.

COMPLETED

O. W. D. D

1935
12/4 Drg 3571
12/23 TD 3578 hung 5"

OVER

12/19 5" 3578 HFW 3579
Top lower WK 3578
TD 3612 WR

12/26 S.D.

1/2/36 Rep. Rig

1/10 TD 3612 log 5"

1/17 Trying to drill up 5"

1/24 log by 5" 3570

1/31 log Bailer

2/7 log on Bailer

2/14 —

2/21 log 3571

2/28 S.D.

3/6 —

3/18 Sank 3611

TD 3612

perforated pipe 2510-3495

D & A

ABANDONED

Map No. 43 Sec. 30 Twp 22 R. 3W

Well No. 5 - Schmidt

Magnolia Company

Contractor

FIRST REPORTS

SECTION PLAT

990 Ft. from N. Line

..... Ft. from S. Line

..... Ft. from E. Line

990 Ft. from W. Line

		0	

Location..... ✓

Rig up.....

Drilling and Remarks:

RECORD

Cased..... in., ft.

Sand.....

Gas.....

Oil.....

Total Depth.....

PRODUCTION

1st 24 hrs. Nat.....

1st 24 hrs. after shot.....

Gas..... Cu. Ft.

Dry Hole.....

Abandoned.....

Date

1-17-34 192 O. Manssbeck Scout

Map No. 43 Sec. 30 Twp. 22 R. 34Well No. 5-SchmidtMagnolia pet Company

Contractor

SECTION PLAT

		0	

990 Ft. from N. Line

_____ Ft. from S. Line

_____ Ft. from E. Line

990 Ft. from W. Line**COMPLETED**

RECORD

Location _____

Cased _____ in., _____ ft.

Rig up _____

Sand Viola 3508

Drilling and Remarks:

Gas _____

Oil _____

Total Depth 3549

PRODUCTION

1st 24 hrs. Nat. _____

1st 24 hrs. after shot _____

Gas _____ Cu. Ft.

Dry Hole _____

Abandoned _____

Date

ORVAL MANNSCHRECK

4-25-34 19

Scout

KANSAS

Map No. 43 Sec. 30 Twp. 22 R. 3W

Well No. 5-Schmidt

Magnolia Pet Company

Contractor

FIRST REPORTS

SECTION PLAT

990 Ft. from N. Line

..... Ft. from S. Line

..... Ft. from E. Line

990 Ft. from W. Line

		o	

Owdd

RECORD

Location.....

Cased..... in., ft.

Rig up.....

Sand.....

Drilling and Remarks:

Gas.....

Oil.....

Total Depth.....

OTQ 3549

1029 3571

PRODUCTION

1st 24 hrs. Nat.....

1st 24 hrs. after shot.....

Gas..... Cu. Ft.

Dry Hole.....

Abandoned.....

Date

MANUSCRIPT

12-4-35 192.....

Scout

KANSAS

Map No. 43 Sec. 30 Twp. 22 R. 3W

Well No. 5-Schmidt

Magnolia Company

Contractor

COMPLETED

SECTION PLAT

990 Ft. from N. Line

..... Ft. from S. Line

..... Ft. from E. Line

990 Ft. from W. Line

		0	

o.w.d.d

Location.....

Rig up.....

Drilling and Remarks:

Perforated pipe
2510-3495

D, + a,

RECORD

Cased.....in.,ft.

Sand 3611

Gas.....

Oil.....

Total Depth 3612

PRODUCTION

1st 24 hrs. Nat.....

1st 24 hrs. after shot.....

Gas.....Cu. Ft.

Dry Hole.....

Abandoned.....

Date

MAR 18 1936

ORVAL MANNSCHRECK

192.....

Scout