


Harvey

Form 51-5M-11-31-Palace

Map No. **KANSAS** Sec. 30 Twp. 22 R. 3W

Well No. 5 Schmidt Farm

H. C. McBride Inc. Company

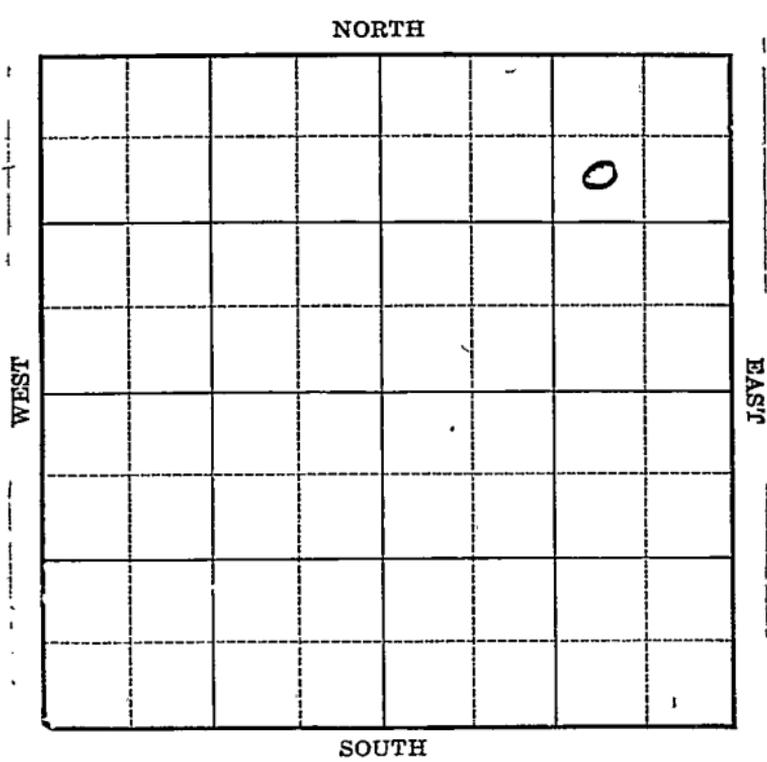

Location _____

Drilling Remarks _____

RECORD

Cased _____ in. _____ ft.

Sand _____

Gas _____

Oil _____

Total Depth _____

Rig Up _____

Drilling Remarks _____

PRODUCTION

1st 24 hrs. Nat. _____

1st 24 hrs. after shot _____

Gas _____ cu. ft.

Dry Hole _____

Abandoned _____

Harvey

Map No. **KANSAS** Sec. 30 Twp 22 R. 3W

Well No. 5 *Schmidt* Farm


N.C. Mc Bride Inc. Company

990 Ft. from N. Line

_____ Ft. from S. Line

990 Ft. from E. Line

_____ Ft. from W. Line

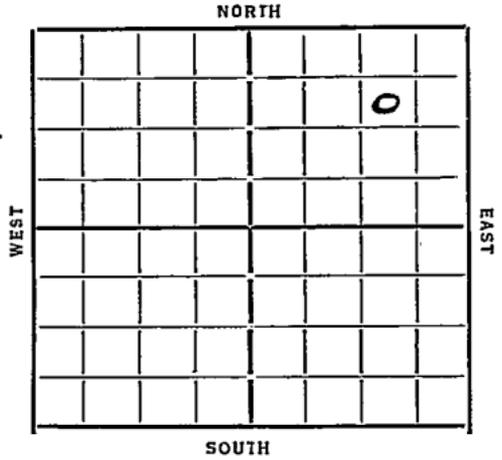

Date	REPORT
1954	
5/2	Bldg Rig
5/10	—
5/18	Rign
5/25	Dlg 220
5/31	" 1061
6/7	" 1970 13" 1825
6/14	W.R. 10" 2410
6/21	Dlg 2450 10" 2377
6/28	Dlg 2779 S.O. 2502-7
7/5	10" 2459 147 1/2 2840-60
	8" 2860 Dlg 2989
7/12	TD 3155 Run 6"
7/19	Chat 3154 6" 3159
7/26	6" 3266 B. Misc 3305
	Dlg 3315
8/2	Hutton 3405 TD 3431
	S.O. 3416
8/8	Hutton 3405 TD 3431
	437 Bbls oil 20 water

COMPLETED

Map No. 430 Sec. 30 Twp. 22 R. 3W

Well No. 5-Schmidt

W. C. McBride, Inc. Company

Contractor

FIRST REPORTS

990 Ft. from N. Line

_____ Ft. from S. Line

990 Ft. from E. Line

_____ Ft. from W. Line

SECTION PLAT

			0

Location _____

Rig up _____

Drilling and Remarks:

Bed Rig

RECORD

Cased _____ in., _____ ft.

Sand _____

Gas _____

Oil _____

Total Depth _____

PRODUCTION

1st 24 hrs. Nat. _____

1st 24 hrs. after shot _____

Gas _____ Cu. Ft.

Dry Hole _____

Abandoned _____

Date

5-2-37 19

ORVAL MANNSCHRECK

Scout

KANSAS

Map No. 43 Sec. 30 Twp. 27 R. 3W

Well No. 5-Schmidt

W. C. McBride Company

[Signature] Contractor

SECTION PLAT

			0

990 Ft. from N. Line

_____ Ft. from S. Line

990 Ft. from E. Line

_____ Ft. from W. Line

Location _____

Rig up _____

Drilling and Remarks:

437 bbl oil
20 water

RECORD

Cased _____ in., _____ ft.

Sand Huntton 3405

Gas _____

Oil _____

Total Depth 3431

PRODUCTION

1st 24 hrs. Nat. _____

1st 24 hrs. after shot _____

Gas _____ Cu. Ft.

Dry Hole _____

Abandoned _____

Date

8-8-37 19

ORIGINAL MANUFACTURED BY

Scout