



Harvey

Map No. KANSAS Sec. 30 Twp 22 R. 3<sup>W</sup>

Well No. 6 Schmitt Farm


Magnolia Company

\_\_\_\_\_ Ft. from N. Line

990 Ft. from S. Line

\_\_\_\_\_ Ft. from E. Line

330 Ft. from W. Line

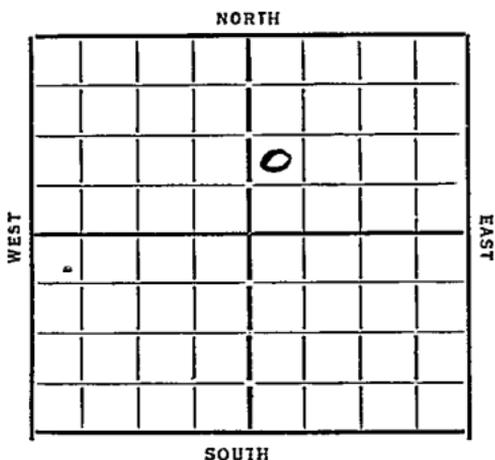

Date 1934 REPORT O. W. D. D

5/2 Bldg Rig  
 5/10 15 1/2 2920 w.o.c.  
 5/18 Dlg 1500  
 5/25 " 2540  
 5/31 " 3085 H.C.L. 2505  
 6/7 Chat 3147 T.D. 3152  
 S.O. Rust  
 6/14 T.D. 3165  
 6/20 Chat 3149 T.D. 3171  
 Flow 125 Bbl.

COMPLETED

1938 O. W. D. D

3/9 Old T.D. 3171' in Chat.  
 Drlg. 3241'  
 3/18 Base Miss. 3292', Drlg. 3340'.  
 3/25 Hunton 3340', 7" @ 3366'.  
 T.D. 3370'. No shows. U. R. 7"

OVER

1938

2/1 Misner 3389', Hunton 3390' - (Corrected)

7" @ 3392'. T.D. 3394' S.O.

WOC.

4/8 T.D. 3400' S.O. & W.

4/15 T.D. 3411'. 1000 acid.

With 130 bbl. load.

Now trying to recover load.

4/20 7" @ 3392'.

Old T.D. 3171'.

Hunton 3390'.

T.D. 3411'.

Potential 29 oil & 72 water.

~~ABANDONED~~

COMPLETED

Harvey  
Form 26-1M Bks. 2-29

KANSAS

Map No. 43 Sec. 30 Twp. 22 R. 3W

Well No. 6 Schmidt

Magnolia Company

Contractor

FIRST REPORTS

\_\_\_\_\_ Ft. from N. Line

990 Ft. from S. Line

\_\_\_\_\_ Ft. from E. Line

330 Ft. from W. Line

SECTION PLAT

		0	

Location \_\_\_\_\_

Rig up \_\_\_\_\_

Drilling and Remarks:

*Beag Rig*

RECORD

Cased \_\_\_\_\_ in., \_\_\_\_\_ ft.

Sand \_\_\_\_\_

Gas \_\_\_\_\_

Oil \_\_\_\_\_

Total Depth \_\_\_\_\_

PRODUCTION

1st 24 hrs. Nat. \_\_\_\_\_

1st 24 hrs. after shot \_\_\_\_\_

Gas \_\_\_\_\_ Cu. Ft.

Dry Hole \_\_\_\_\_

Abandoned \_\_\_\_\_

Date

5-2-34 19

ORVAL MANNSCHRECK Scout

Map No. 43 Sec. 30 Twp. 27 R. 3W

Well No. 6-Schmitt

Magnolia pet Company

Contractor

**COMPLETED**

**SECTION PLAT**

		0	

\_\_\_\_\_ Ft. from N. Line

990 Ft. from S. Line

\_\_\_\_\_ Ft. from E. Line

330 Ft. from W. Line

Location \_\_\_\_\_

Rig up \_\_\_\_\_

Drilling and Remarks:

Flow 125 bbls

**RECORD**

Cased \_\_\_\_\_ in., \_\_\_\_\_ ft.

Sand Chat 3147

Gas \_\_\_\_\_

Oil \_\_\_\_\_

Total Depth 3171

**PRODUCTION**

1st 24 hrs. Nat. \_\_\_\_\_

1st 24 hrs. after shot \_\_\_\_\_

Gas \_\_\_\_\_ Cu. Ft.

Dry Hole \_\_\_\_\_

Abandoned \_\_\_\_\_

**ORVAL MANNSCHECK**

Date

6-20-37 19

Scout

Map No. 43 Sec. 30 Twp. 22 R. 3WWell No. 6 SchmidtMagnolia

Company

Contractor

## FIRST-REPORT

## SECTION PLAT

NW SW NE

Ft. from N. Line

990 Ft. from S. Line

Ft. from E. Line

330 Ft. from W. Line

O. W. D. D

		0	

Location \_\_\_\_\_

Rig up \_\_\_\_\_

Drilling and Remarks:

OTD 3171 in Chat  
Drlg. 3241

## RECORD

Cased \_\_\_\_\_ in., \_\_\_\_\_ ft.

Sand \_\_\_\_\_

Gas \_\_\_\_\_

Oil \_\_\_\_\_

Total Depth \_\_\_\_\_

## PRODUCTION

1st 24 hrs. Nat. \_\_\_\_\_

1st 24 hrs. after shot \_\_\_\_\_

Gas \_\_\_\_\_ Cu. Ft.

Dry Hole \_\_\_\_\_

Abandoned \_\_\_\_\_

Date

MAR 9 - 1938 19

H. D. Hatfield Scout

Harvey

KANSAS

Map No. 43 Sec. 30 Twp. 22 R. 3W

Well No. 6 Schmidt

Magnolia

Company

Contractor

**COMPLETED**

NW SW NE

**SECTION PLAT**

		0	

\_\_\_\_\_ Ft. from N. Line

990 Ft. from S. Line

\_\_\_\_\_ Ft. from E. Line

330 Ft. from W. Line

Location \_\_\_\_\_

Rig up \_\_\_\_\_

Drilling and Remarks:

OWDD OTD 317

POT 29 oil  
72 wt

**RECORD**

Cased 7 in., 3392 ft.

Sand Hunton 3390

Gas \_\_\_\_\_

Oil \_\_\_\_\_

Total Depth 3411

**PRODUCTION**

1st 24 hrs. Nat. \_\_\_\_\_

1st 24 hrs. after shot \_\_\_\_\_

Gas \_\_\_\_\_ Cu. Ft.

Dry Hole \_\_\_\_\_

Abandoned \_\_\_\_\_

Date

APR 20 1938

19

H. D. Hatfield

Scout