

KANSAS

Spencer


Form 51-5M-11-31-Palace

Map No. Sec. 30 Twp. 22 R. 3 W

Well No. 1 K. Schmidt Farm

Magnolia Company

NORTH

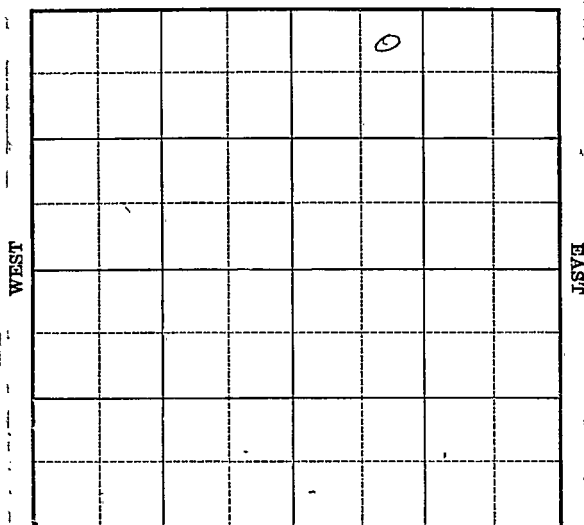

SOUTH

Location

Drilling Remarks

Rig Up

Drilling Remarks

RECORD

Cased in. ft.

Sand

Gas

Oil

Total Depth

PRODUCTION

1st 24 hrs. Nat.

1st 24 hrs. after shot

Gas cu. ft.

Dry Hole

Abandoned


Harvey

KANSAS

Map No. _____ Sec. 30 Twp. 22 R. 3^wWell No. #1 R. Schmidt FarmMagnolia Pet Company330 Ft. from N. Line

_____ Ft. from S. Line

_____ Ft. from E. Line

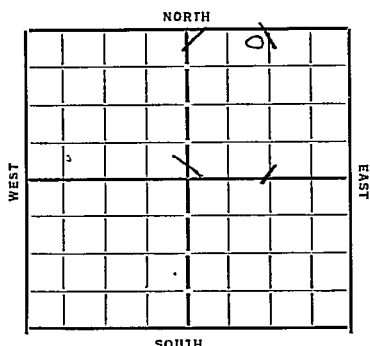990 Ft. from W. Line

Date

REPORT

19333/22

Cellar

3/29

Repair

4/4

drilling 20" 150'

4/12

20" 235 15" 490 drlg 750'

4/19

13" - 1547 - drlg 1620'

4/26

drlg 2140'

5/4

10" 2230' T.D. 2285 - U.R. 10"

5/10Top K.C. line 2499 Oil 2508-13
Est 45 bbls show T.D. 25205/17

Will Perdue

5/171000 gal acid pump 224 bbls
1-14 1/2 hrs5/24

Swat 213 Bbl 24 hours.

6/1

pump 6 1/2 Bbl per hour

6/8

—

6/1551 bbls oil 2 bbls water 24 hrs
T.D. 2520'6/21

—

6/27

—

7/12

T.D. 2520

50 bbls

COMPLETED

43 **KANSAS** *Harvey* W
 Map No. _____ Sec. *30* Twp. *22* R. *3*
 Well No. *1* *K. Schmier*
Magnolia Oil Co Company
 _____ Contractor

FIRST REPORTS

330 Ft. from N. Line

_____ Ft. from S. Line

_____ Ft. from E. Line

990 Ft. from W. Line

SECTION PLAT

		<i>0</i>	

Location _____

Rig up _____

Drilling and Remarks:

Cellar

RECORD

Cased _____ in., _____ ft.

Sand _____

Gas _____

Oil _____

Total Depth _____

PRODUCTION

1st 24 hrs. Nat. _____

1st 24 hrs. after shot _____

Gas _____ Cu. Ft.

Dry Hole _____

Abandoned _____

Date

MAR 2 2 1933 ₁₉₂ **CHAS. L. SHERWOOD** Scout

Harvey
 Map No. 43 Sec. 30 Twp. 22 R. 3W
 Well No. 1- K. Schmidt
 Magnolia Petroleum Company
 Contractor

SECTION PLAT

330 Ft. from N. Line

Ft. from S. Line

Ft. from E. Line

990 Ft. from W. Line

COMPLETED

		0	

Location.....

Rig up.....

Drilling and Remarks: **COMPLETED**

RECORD

Cased.....in.,ft.

Sand.....

Gas.....

Oil.....

Total Depth 2520

PRODUCTION

1st 24 hrs. Nat.....

1st 24 hrs. after shot.....

Gas.....Cu. Ft.

Dry Hole.....

Abandoned.....

Date

7/12/33 192 Owal Mannesman